IREDELL COUNTY HEALTH DEPARTMENT

Statesville Office (704) 878-5305 Mooresville Office (704) 660-3625 PERMIT # 211231

IMPROVEMENT PERMIT / AUTHORIZATION TO CONSTRUCT / OPERATION PERMIT / EXISTING SYSTEM

PIN # 4765528739

APPLICANT: Gary Wesley APPLICANT ADDRESS: 162 Twin Lakes Dr

SITE ADDRESS: 147 Maple Leaf Rd Statesville NC 28625 PHONE: 1-704-878-2725 ALT. PHONE: N/A

SITE DIRECTIONS: East on 64 T/R Bell Farm Rd T/L Maple Leaf Rd Lot on left

SUBDIVISION: Cedar Hills SECTION: N/A LOT # 58 LOT AREA: 0.62ac DESIGN FLOW: 360 L.T.A.R.: Ex

Septic Tank 1000 (gal) STB 160 Date 5-11-15
Pump Tank N/A (gal) PT N/A Date N/A
Pump Make N/A Model Lowlow Serial # PL-60
Nitrification Fields Ex # Lines Ex Linear Ft: Ex
Trench Width Ex Max. Trench Bottom Depth Ex Gravel Depth Ex


☐ New System ☒ Repair ☐ Expansion System Type: I ☒ II III IV V VI
System Description: Tank
Repair System Description:
Maintenance Agreement Required: ☐ YES ☒ NO
☑ GRAVITY ☐ PRESSURE

☒ Residence No. Bedrooms Ex 3
☐ Business No. Persons Ex
☐ Other No. Employees
☐ Slab ☒ Crawl Space
☐ Basement w/plumbing ☐ Basement w/o plumbing


Water Supply: ☐ Private ☒ Public ☐ Community

Comments / Conditions: Pump, crush & fill existing tank. Maintain 5' off any building foundation 12" risers installed

INITIAL SITE SKETCH

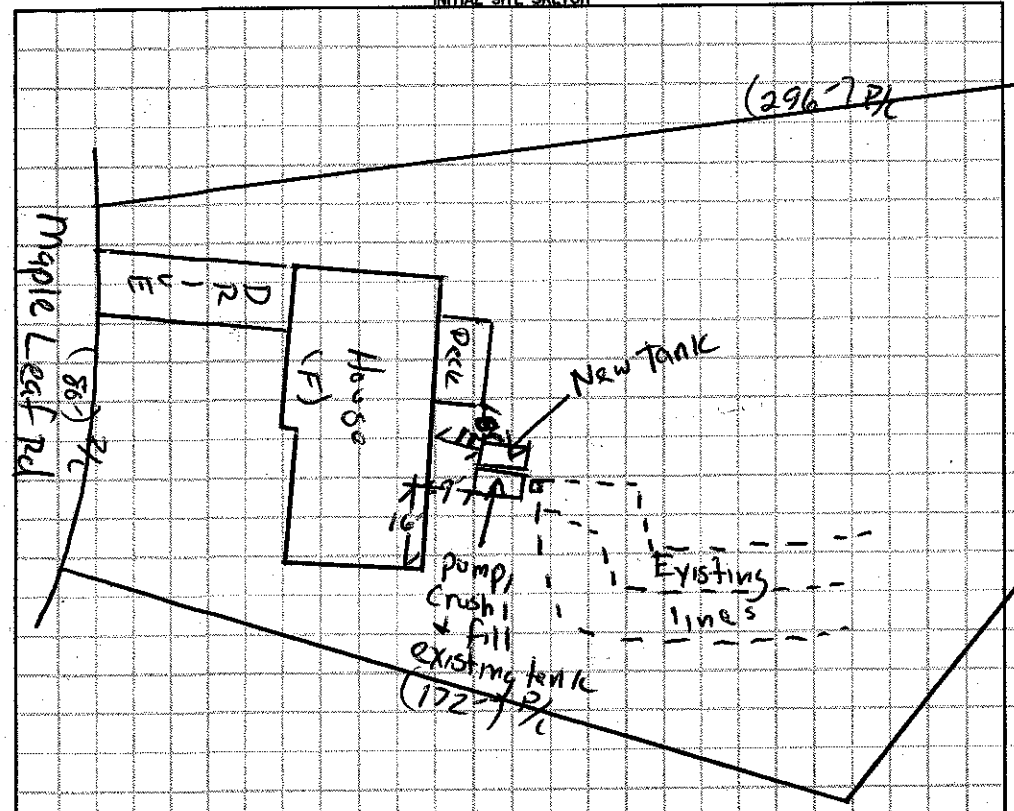

AS BUILT SKETCH

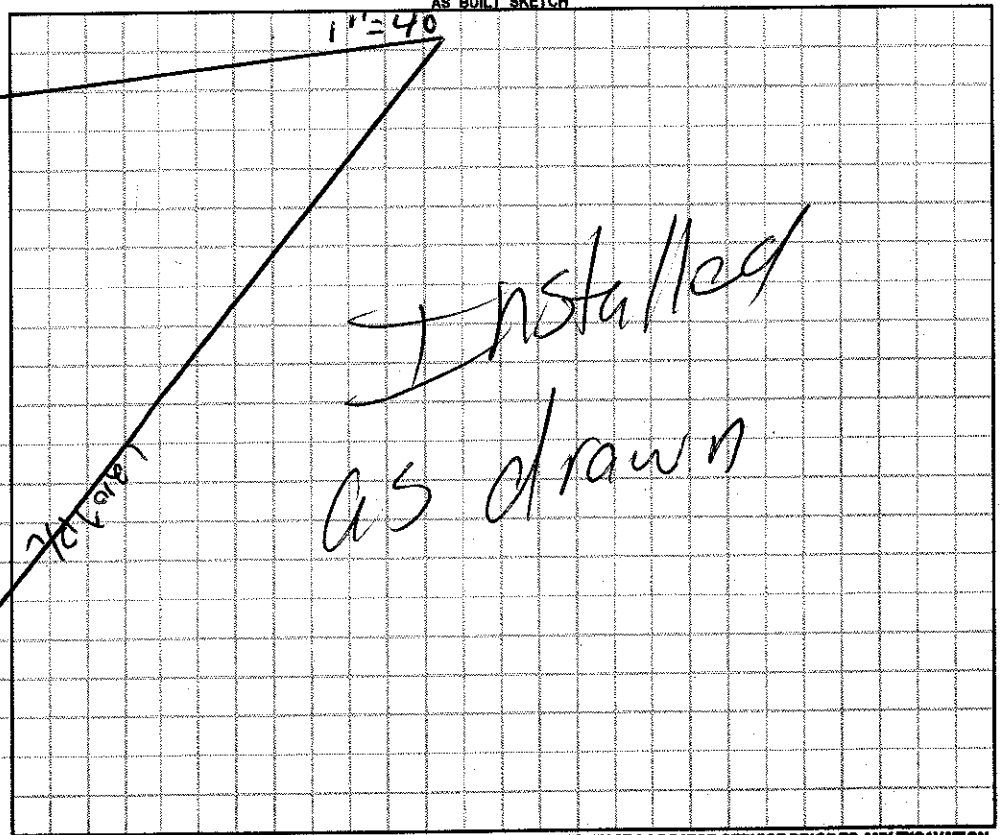

Permit can be suspended or revoked if any false information is supplied toward securing the permit / any unauthorized changes are made to the site / any unauthorized changes are made in the installation of the system. **CONTACT A LOCATOR SERVICE PRIOR TO ANY EXCAVATION**

☐ **IMPROVEMENT PERMIT** *with plat valid without expiration.* ☒ **IMPROVEMENT PERMIT** *with site plan valid for 60 mos.* ☑ **AUTHORIZATION TO CONSTRUCT** *valid for period equal to IMPROVEMENT PERMIT--not to exceed 60 mo.*

Owner / Applicant Signature: Date: 6/16/15 Installed by: Kevin Bowles

IMPROVEMENT PERMIT by: Date: 06/16/15 OPERATION PERMIT by: Date: 06/18/15

AUTHORIZATION TO CONSTRUCT by: Date: 06/16/15 Existing System Inspected by: Date:

Health Dept. Copy - WHITE Applicant (Final Approval) - YELLOW Applicant (Conditional Approval) - PINK