IREDELL COUNTY HEALTH DEPARTMENT

STATESVILLE 704-878-5305 MOORESVILLE 704-664-5281

IMPROVEMENT PERMIT / AUTHORIZATION TO CONSTRUCT / OPERATION PERMIT / EXISTING SYSTEM INSPECTION

PERMIT# REPAIR PIN# 4765-53-5805 DATE 8-5-04

OWNER OR CONTRACTOR WAYNE A. SHERRILL PHONE: Business Home 704-838-1029

ADDRESS 117 AIRBORNE LANE, STATESVILLE NC 28625

LOCATION US 64 EAST, TL AIRBORNE LANE, 1ST HOUSE ON LEFT

SUBDIVISION BLOCK / SECTION LOT LOT AREA 1.076 ACRES SITE CLASS. PS DESIGN FLOW 240 L.T.A.R. EXISTING

Septic Tank: EXISTING Gallons; STB Date

Pump Tank: Gallons; PT Date

Pump Make: Model Serial No.

Nitrification Field: No Fields 1 Square Feet 480 Linear Feet 160

No Lines TWO Trench Width 36" Max Trench Bottom Depth 36" Gravel Depth 12"

☒ New System ☒ Repair System Type: (II), III, IV, V, VI

System Description:

Repair System Description: CONVENTIONAL, GRAVITY

Maintenance Agreement Required: ☐ Yes ☒ No

☒ House/Mod. Home No. Bedrooms 2

☐ Mobile Home No. Bathrooms 1

☐ Business No. Employees

☐ Other


☐ Slab ☐ Crawl Space ☒ Basement w/plumbing ☐ Basement wo/plumbing

Water Supply: ☐ Individual ☐ Public ☐ Community

Comments:/Conditions: INSTALL NEW SANITARY TEE IN SEPTIC TANK IF NECESSARY. INSTALL NEW DRAINLINES OVER EXISTING AS SHALLOW AS POSSIBLE (NO DEEPER THAN 36") ON CONTOUR AS FLAGGED

Comments:/Conditions:

INITIAL SITE SKETCH

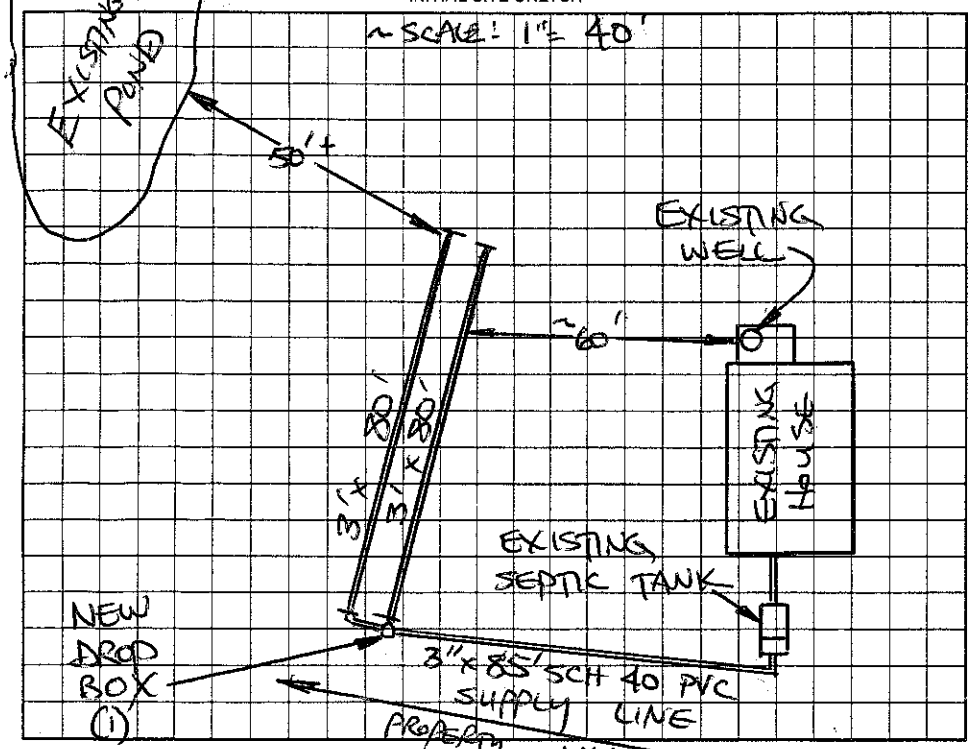

AS BUILT SKETCH

SYSTEM REPAIRED ACCORDING TO INITIAL SITE SKETCH

Permit can be suspended or revoked if any false information is supplied toward securing the permit/any unauthorized changes are made to the site/any unauthorized changes are made in the installation of the system. Improvement Permit with plat valid without expiration. Improvement Permit with site plan valid for sixty months. Authorization to Construct is valid for a period equal to that of Improvement Permit – not to exceed sixty months.

Signed: Wayne Sherrill date 8-5-04

Improvement Permit by: STEVE HEDRICK date 8-5-04

Authorization to Construct by: STEVE HEDRICK date 8-5-04

Installed by: JAMES HUDLER

Operation Permit by: STEVE HEDRICK date 1-3-05

Existing System Inspection by: date

HEALTH DEPT. COPY: WHITE OWNER COPY (FINAL): YELLOW OWNER COPY (INITIAL): PINK