IREDELL COUNTY HEALTH DEPARTMENT

STATESVILLE 704-878-5305 MOORESVILLE 704-664-5281

IMPROVEMENT PERMIT / AUTHORIZATION TO CONSTRUCT / OPERATION PERMIT / EXISTING SYSTEM INSPECTION

PERMIT# 72628 PIN# 4765543736 DATE 4-1-98

OWNER OR CONTRACTOR Paul Hildebran PHONE: Business 704-256-7222 Home

ADDRESS 4431 116th St. Drive NE Hickory

LOCATION 64E 76 Rivermill TR Essie Lin at end

SUBDIVISION BLOCK / SECTION LOT LOT AREA 29.1 acres SITE CLASS. PS DESIGN FLOW 360 L.T.A.R. .35

Septic Tank: 1000 Gallons; STB 160 Date 1-14-99
Pump Tank: Gallons; PT Date
Pump Make: Model Serial No.
Nitrification Field: No Fields 1 Square Feet 1045 Linear Feet 345
No Lines 3 Trench Width 36" Max Trench Bottom Depth 36" Gravel Depth 12"

[x] New System [ ] Repair System Type: [x] I [ ] II, [ ] IV, [ ] V, [ ] VI
System Description: Conv. Gravity
Repair System Description:
Maintenance Agreement Required: [ ] Yes [x] No
[ ] Slab [ ] Crawl Space [x] Basement w/plumbing [ ] Basement wo/plumbing


[x] House/Mod. Home No. Bedrooms 3
[ ] Mobile Home No. Bathrooms 2
[ ] Business No. Employees
[ ] Other

Water Supply: [x] Individual [ ] Public [ ] Community


Comments:/Conditions:

Comments:/Conditions:

INITIAL SITE SKETCH

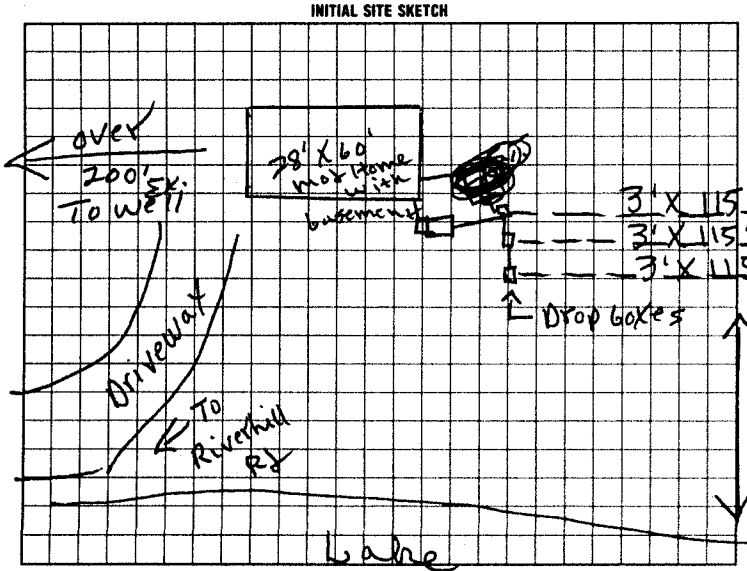

AS BUILT SKETCH

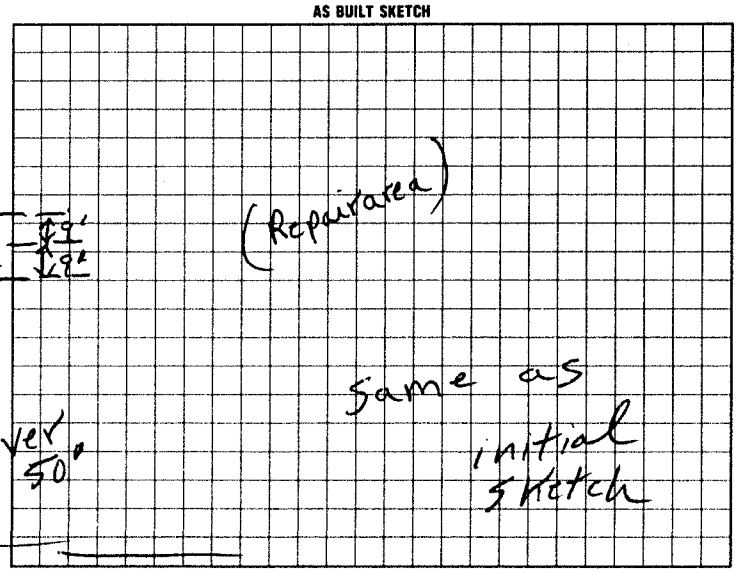

I understand that this permit can be suspended or revoked if any false information is supplied toward securing the permit/any unauthorized changes are made to the site/any unauthorized changes are made in the installation of the system. Improvement Permit with plat valid without expiration. Improvement Permit with site plan valid for sixty months. Authorization to Construct is valid for a period equal to that of Improvement Permit – not to exceed sixty months.

Signed: X Paul Hildebran date

Improvement Permit by: R. C. Moore date 4-1-98

Authorization to Construct by: R. C. Moore date 4-1-98

Installed by: Shane Jarrett Grading

Operation Permit by: R. C. Moore date 3-19-99

Existing System Inspection by: date

HEALTH DEPT COPY WHITE | INSPECTION COPY (FINAL) GREEN | OWNER COPY (FINAL) YELLOW | INSPECTION COPY (INITIAL) PINK | OWNER COPY (INITIAL) GOLD