IREDELL COUNTY HEALTH DEPARTMENT

STATESVILLE 704-878-5305 MOORESVILLE 704-664-5281

TOTAL FEE PAID $330.00 ($175 INITIAL / 155 REMAINING)

IMPROVEMENT PERMIT / AUTHORIZATION TO CONSTRUCT / OPERATION PERMIT / EXISTING SYSTEM INSPECTION

PERMIT# ~~82696~~ 15172 PIN# 4765 53 ~~5950~~ 5805 DATE 7-19-99

OWNER OR CONTRACTOR Wayne A Sherrill PHONE: Business Home 8381029

ADDRESS 675 Mocksville Hwy

LOCATION 64E TL Past Sub station TL Atent

SUBDIVISION BLOCK / SECTION LOT LOT AREA 1.5 acres SITE CLASS. PS DESIGN FLOW 360 L.T.A.R. .35

Septic Tank: 1000 Gallons; STB 1012 Date 1-24-03

Pump Tank: Gallons; PT Date

Pump Make: Model Serial No. 760

Nitrification Field: No Fields 1 Square Feet 1050 Linear Feet ~~350~~

No Lines ~~84~~ Trench Width 36" Max Trench Bottom Depth 36" Gravel Depth 12"

☑ New System ☐ Repair System Type: I, II, III, IV, V, VI

System Description: ~~25% REDUCTION~~ Gravity

Repair System Description: Pump to 25% Red.

Maintenance Agreement Required: ☐ Yes ☑ No

☐ House/Mod. Home No. Bedrooms 3

☑ Mobile Home No. Bathrooms 2

☐ Business No. Employees

☐ Other


☐ Slab ☑ Crawl Space ☐ Basement w/plumbing ☐ Basement wo/plumbing

Water Supply: ☑ Individual ☐ Public ☐ Community


Comments/Conditions: Pond

Comments/Conditions: ① SEPTIC TANK WITH MARKER INSTALLED USING "TUFTITE" FILTER ② SYSTEM ALTERED TO 25% REDUCTION AS SHOWN W/ OWNER & H.D. APPROVAL

INITIAL SITE SKETCH

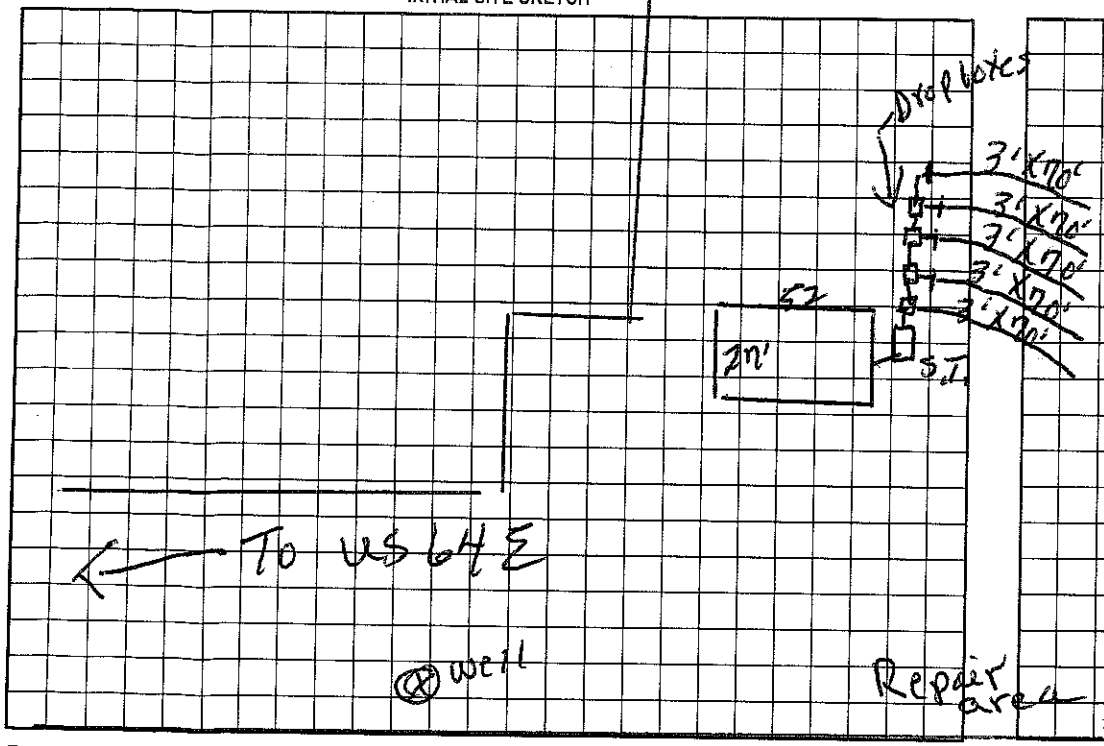

AS BUILT SKETCH

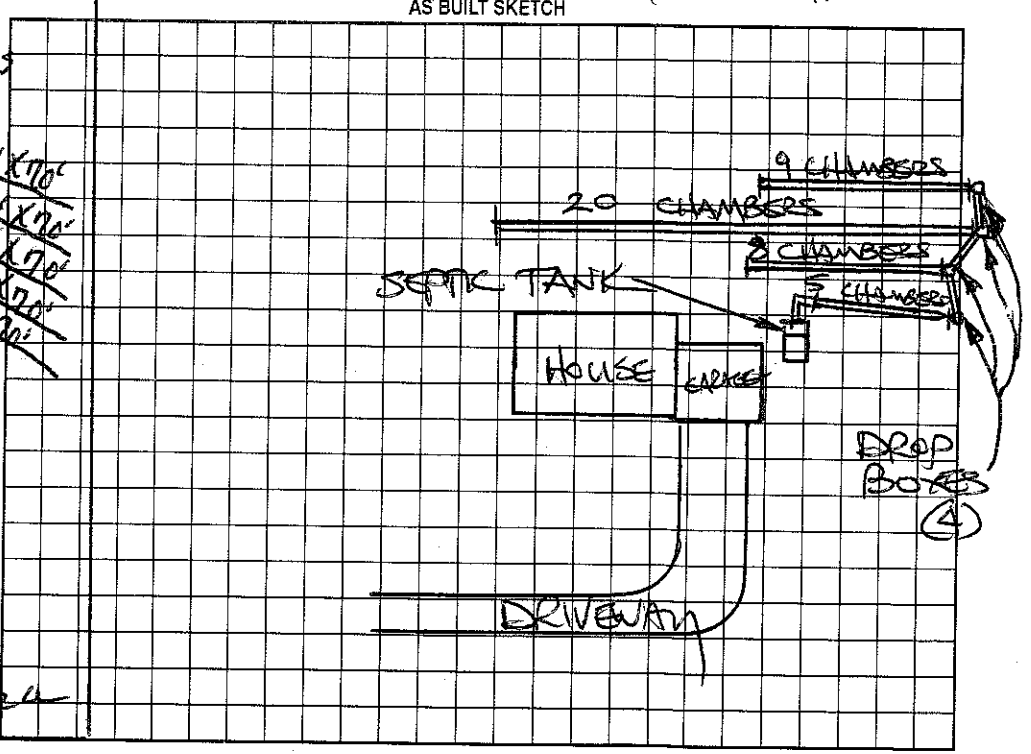

Permit can be suspended or revoked if any false information is supplied toward securing the permit/any unauthorized changes are made to the site/any unauthorized changes are made in the installation of the system. Improvement Permit with plat valid without expiration. Improvement Permit with site plan valid for sixty months. Authorization to Construct is valid for a period equal to that of Improvement Permit – not to exceed sixty months.

Signed: x Wayne A Sherrill date Installed by: TOMMY FRYE

Improvement Permit by: R. C. Moore date 7-19-99 Operation Permit by: STEVE HENDRICK date 8-22-03

Authorization to Construct by: R. C. Moore date 7-19-99 Existing System Inspection by: date

HEALTH DEPT. COPY: WHITE OWNER COPY (FINAL): YELLOW OWNER COPY (INITIAL): PINK