IREDELL COUNTY HEALTH DEPARTMENT

STATESVILLE 704-878-5305 (ad) MOORESVILLE 704-664-5281

IMPROVEMENT PERMIT / AUTHORIZATION TO CONSTRUCT / OPERATION PERMIT / EXISTING SYSTEM INSPECTION

PERMIT# 148053 PIN# 4765551356 96 DATE 4-23-08

OWNER OR APPLICANT Elston Homes PHONE: Business 704-902-0167 Home

ADDRESS Box 423 Statesville NC 28687

LOCATION 64 E (TO Mocksville (TO Westhaven At End

SUBDIVISION Countrywood BLOCK / SECTION LOT 11 LOT AREA .94 SITE CLASS. PS DESIGN FLOW 360 L.T.A.R. 275 .75 Repair

Septic Tank: 1,000 Gallons; STB 1012 Date 10-307

Pump Tank: 1000 Gallons; PT 17 Date 32408

Pump Make: Gorilla Model 1/3 1/60 Serial No WC0311 N

Nitrification Field: No Fields Square Feet 1310 Linear Feet 320

No Lines 4 Trench Width 36" Max Trench Bottom Depth 36" Gravel Depth

☑ New System ☐ Repair ☐ Expansion System Type: I II III IV V VI

System Description: 25% Pump

Repair System Description: 50% Low Pres

Maintenance Agreement Required: ☐ Yes ☐ No

☐ Gravity ☑ Pressure ☐ Slab ☑ Crawl Space ☐ Basement w/plumbing ☐ Basement wo/plumbing

☐ House/Mod. Home No. Bedrooms 3

☐ Mobile Home No. Persons

☐ Business No. Employees

☐ Other

Water Supply: ☐ Individual ☑ Public ☐ Community

Comments:/Conditions:

Install as Easton
Maintain all setbacks

INITIAL SITE SKETCH

(See Attached by SEHE)

Comments:/Conditions:

#36" Trench Bottom (must)
#25' upslope from drainageway

AS-BUILT SKETCH

Trench Lines to
Septic Manhole
Checked Lines
Pump Test
Manifold
Tank

4-26-08

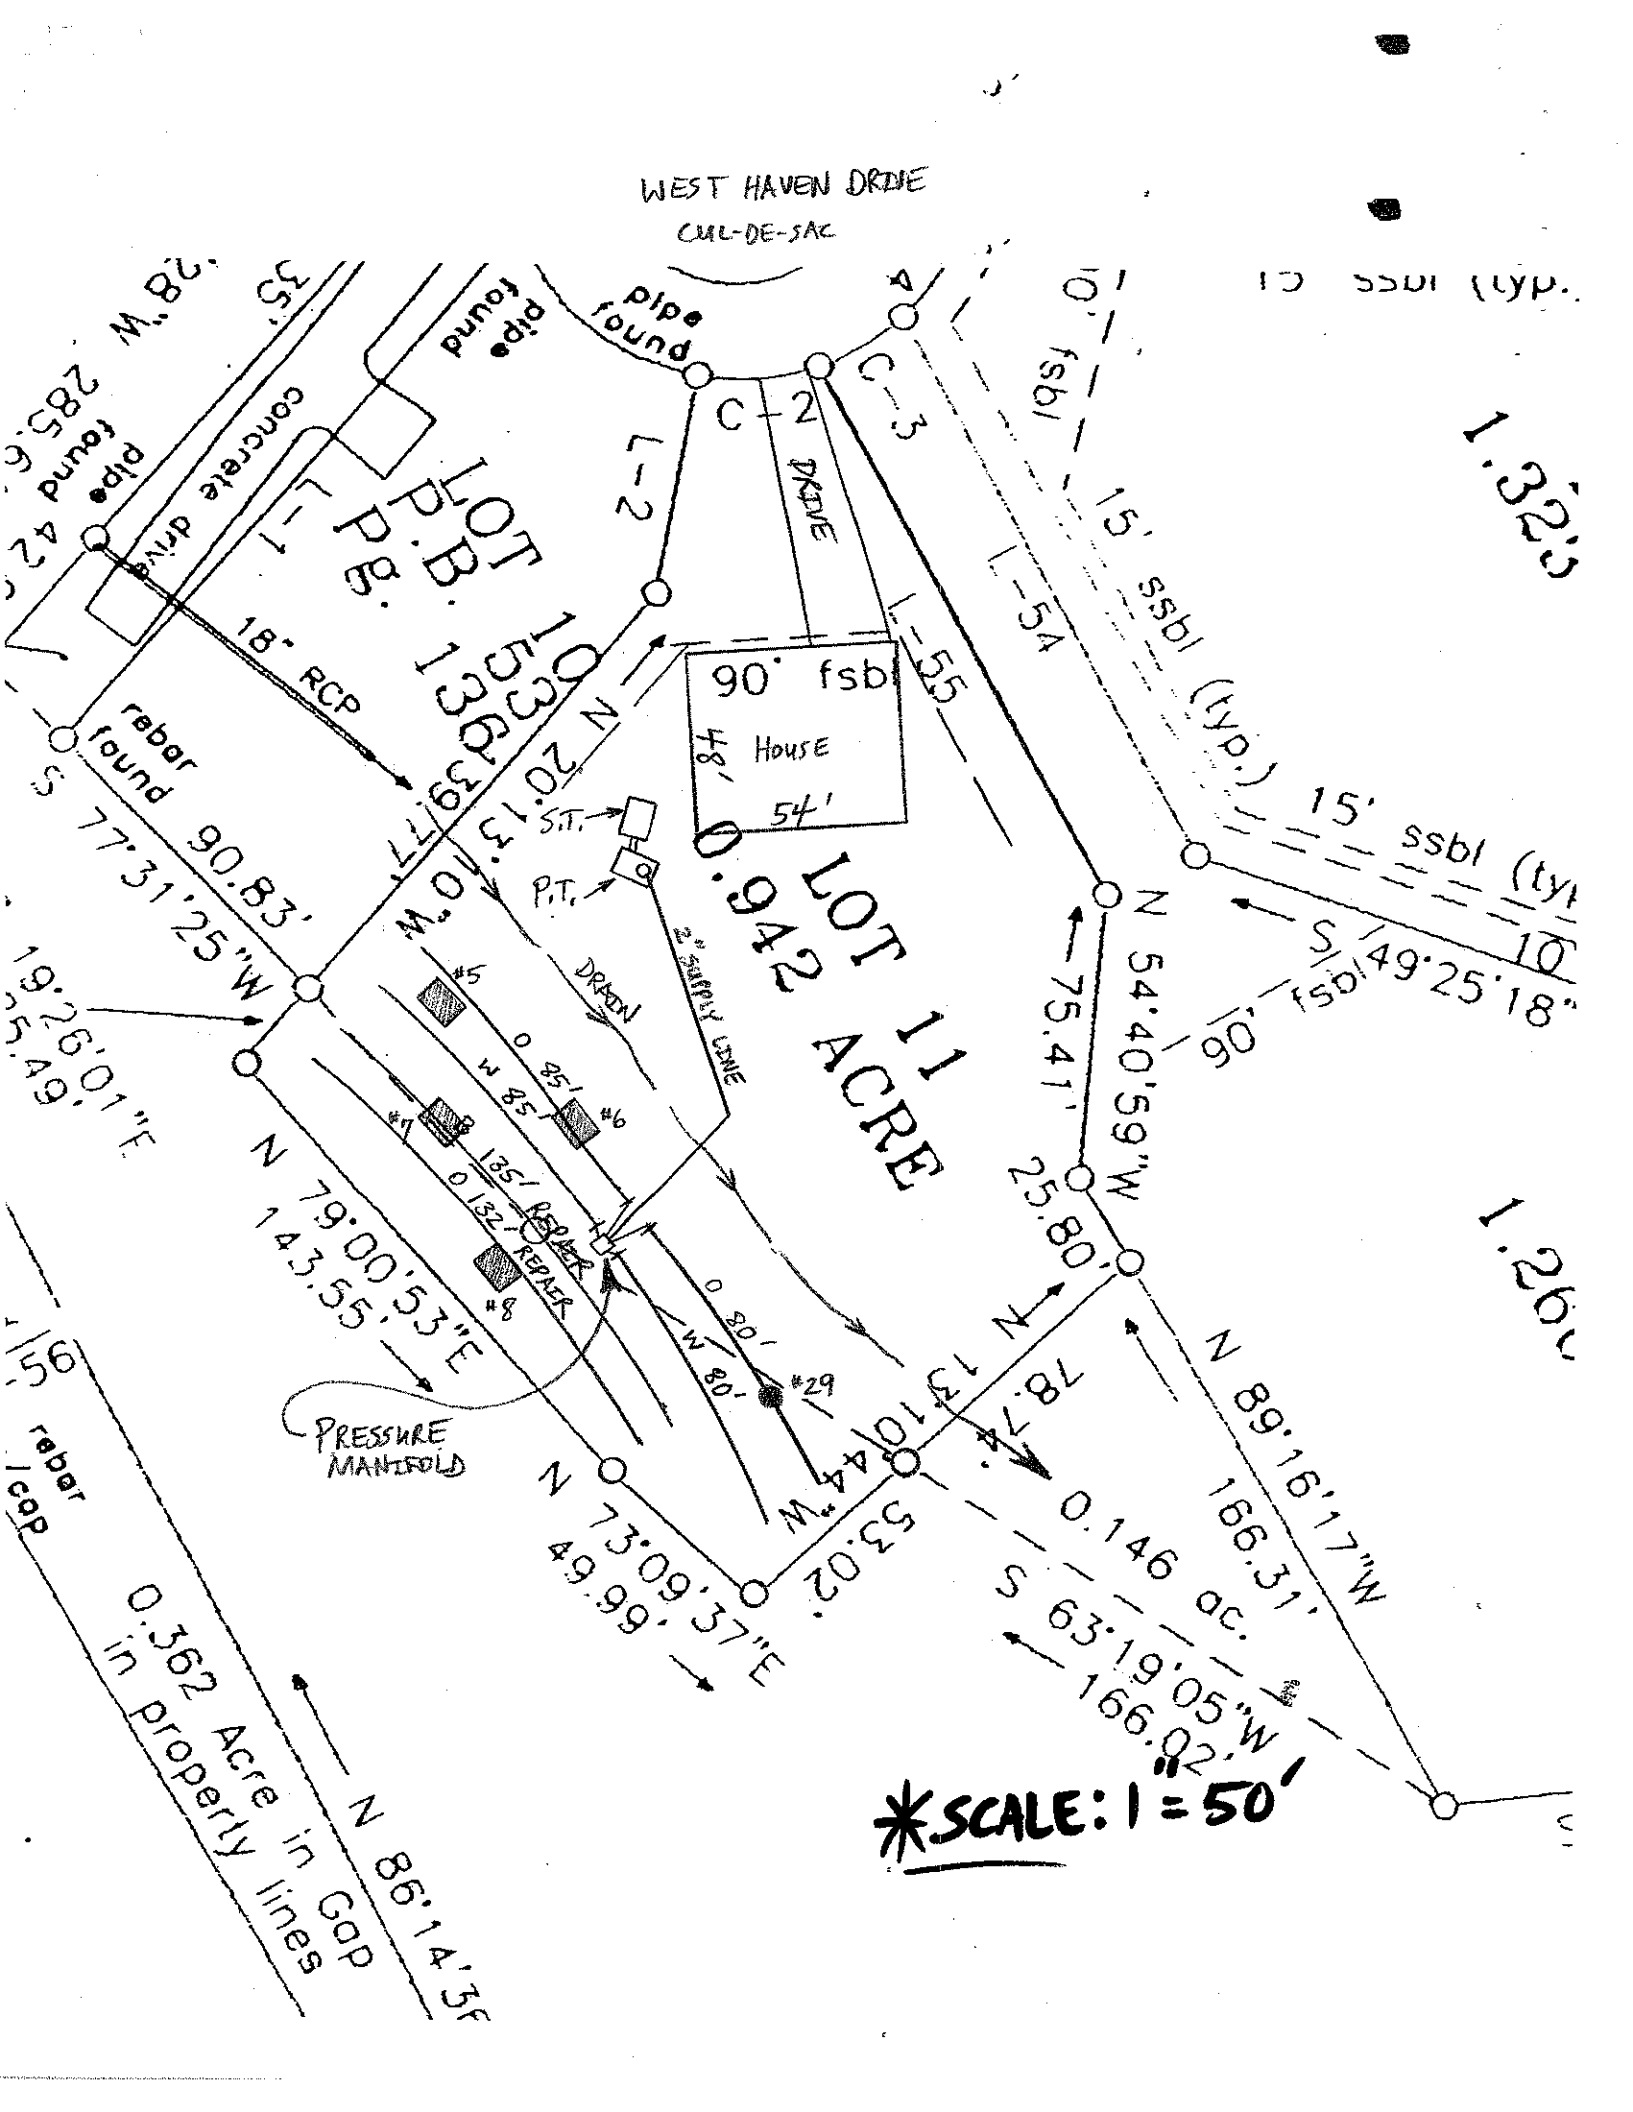
Permit can be suspended or revoked if any false information is supplied toward securing the permit/any unauthorized changes are made to the site/any unauthorized changes are made in the installation of the system. Improvement Permit with plat valid without expiration ☐ Improvement Permit with site plan valid for sixty months ☑ Authorization to Construct is valid for a period equal to that of Improvement Permit – not to exceed sixty months.

Signed: date 4-23-08 Installed by: Chris Thompson

Improvement Permit by: date 4-23-08 Operation Permit by: date 5-13-08

Authorization to Construct by: date 4-23-08 Existing System Inspection by: date

HEALTH DEPT. COPY: WHITE OWNER COPY (FINAL): YELLOW OWNER COPY (INITIAL): PINK


WEST HAVEN DRIVE
CUL-DE-SAC
pipe found
pipe found
concrete drive
18" RCP
rebar found
S 77°31'25"W 90.83'
S 19°26'01"E 95.49'
LOT 11
C-1
C-2
C-3
L-2
L-54
L-55
DRIVE
90' fsb
48'
54'
House
N 20°13'39"W 75.41'
N 54°40'59"W 25.80'
N 78°13'10"W 78.74'
N 89°16'17"W 166.31'
S 63°19'05"W 166.02'
0.942 ACRE
0.146 ac.
0.362 Acre in Gap
in property lines
N 86°14'35"E
S 49°25'18"E
15' ssbl (typ.)
S.T.
P.T.
2" SUPPLY LINE
DRAIN
#5
#6
#7
#8
#29
PRESSURE MANIFOLD
N 79°00'53"E 143.55'
N 73°09'37"E 49.99'
53.02'
1.32
1.26
rebar
1 cap
*SCALE: 1 = 50'