IREDELL COUNTY HEALTH DEPARTMENT

STATESVILLE 704-878-5305 (1) MOORESVILLE 704-664-5281

IMPROVEMENT PERMIT / AUTHORIZATION TO CONSTRUCT / OPERATION PERMIT / EXISTING SYSTEM INSPECTION

PERMIT# 113457 PIN# 4965-55-9876 DATE 7/2/03

OWNER OR CONTRACTOR Jeff Sherrill PHONE: Business — Home (704) 871-2194

ADDRESS 131 Riser Lane Statesville, NC 28625

LOCATION Hwy 64 East (L) River Hill Road, (R) Oak Haven Drive, lot on right

SUBDIVISION Country Woods BLOCK / SECTION — LOT 42 LOT AREA ± .489 Ac. SITE CLASS. PS DESIGN FLOW 360 L.T.A.R. .30

Septic Tank: 4000 Gallons; STB 1012 Date 9-1-03
Pump Tank: Gallons; PT Date
Pump Make: Model Equ to Serial No.
Nitrification Field: No Fields 1 Square Feet 1,200 Linear Feet 300
No Lines 4 Trench Width 36" Max Trench Bottom Depth 30" Gravel Depth N/A

☒ New System ☐ Repair System Type: I, II, (III), IV, V, VI
System Description: Gravity, 25% Reduction
Repair System Description: Pump, 50% Reduction
Maintenance Agreement Required: ☐ Yes ☐ No

☒ House/Mod. Home No. Bedrooms 3
☐ Mobile Home No. Bathrooms 2½
☐ Business No. Employees
☐ Other


☐ Slab ☒ Crawl Space ☐ Basement w/plumbing ☐ Basement wo/plumbing

Water Supply: ☐ Individual ☒ Public ☐ Community

Comments:/Conditions: (1) Install lines on contour (2) maintain proper setbacks

Comments:/Conditions (1) SEPTIC TANK WITH MARKER INSTALLED USING "TUFTITE" FILTER (2) CHROMA 2 MOTTLES NOTED AT VARIOUS LOCATIONS DURING FINAL INSPECTION

INITIAL SITE SKETCH

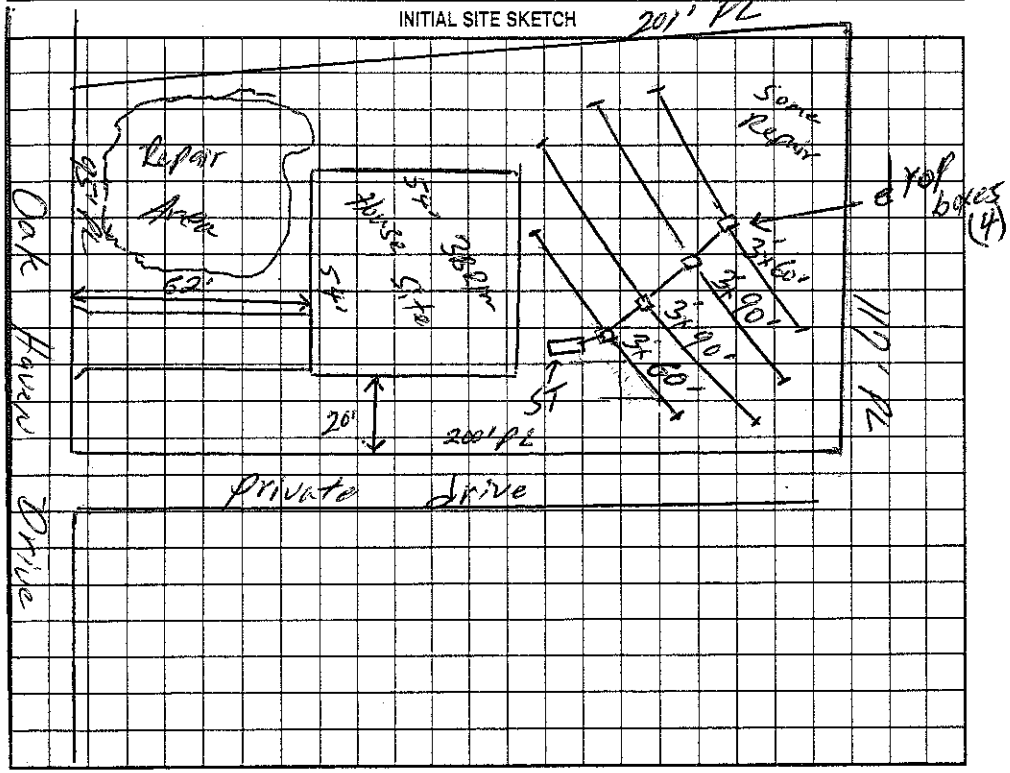

AS BUILT SKETCH

SYSTEM INSTALLED ACCORDING TO INITIAL SITE SKETCH

Permit can be suspended or revoked if any false information is supplied toward securing the permit/any unauthorized changes are made to the site/any unauthorized changes are made in the installation of the system. Improvement Permit with plat valid without expiration. Improvement Permit with site plan valid for sixty months. Authorization to Construct is valid for a period equal to that of Improvement Permit – not to exceed sixty months.

Signed: Jeff Sherrill date 7/3/03
Improvement Permit by: William O. Johnson date 7/3/03
Authorization to Construct by: William O. Johnson date 7/3/03

Installed by: DAVID YOUNTZ
Operation Permit by: STEVE HENDRICK date 2-23-04
Existing System Inspection by: date

HEALTH DEPT. COPY: WHITE OWNER COPY (FINAL): YELLOW OWNER COPY (INITIAL): PINK