IREDELL COUNTY HEALTH DEPARTMENT

STATESVILLE 704-878-5305 MOORESVILLE 704-664-5281

IMPROVEMENT PERMIT / AUTHORIZATION TO CONSTRUCT / OPERATION PERMIT / EXISTING SYSTEM INSPECTION

PERMIT# ✓ PIN# 4765-56-2153 PT DATE 03-15-02

OWNER OR CONTRACTOR RANDALL + REGINA BROWN PHONE Business 704-872-7268 Home

ADDRESS 1005-3 FOXCROFT LANE STATESVILLE NC 28625

LOCATION 64 E, ⓓ RIVERHILL Ⓔ OAKHAVEN, Ⓕ STOCKBRIDGE, ON LFT 8-4 CUL-DE-SAC

SUBDIVISION COUNTRYWOOD BLOCK / SECTION LOT 1 LOT AREA 229000 ft² SITE CLASS PS DESIGN FLOW 480 L.T.A.R. .3

EXISTING

Septic Tank: 1000 Gallons: STB 156 Date 1-01-01
Pump Tank: Gallons: PT Date
Pump Make: Model Serial No
Nitrification Field: No Fields 1 Square Feet 1200 Linear Feet 400
No Lines 8 Trench Width 36" Max Trench Bottom Depth 36" Gravel Depth N/A

New System X Repair System Type I. II. III. IV. V.
System Description:
Repair System Description:
Maintenance Agreement Required Yes X No

X House/Mod Home No. Bedrooms 4
Mobile Home No. Bathrooms 3½
Business No. Employees
Other


Slab Crawl Space X Basement w/plumbing Basement wo/plumbing

Water Supply: ☐ Individual ☒ Public ☐ Community

Comments/Conditions: CALL WHEN DONE & LET ENV HEALTH SPEC. CHECK IT.

Comments/Conditions:

INITIAL SITE SKETCH "NOT TO SCALE"

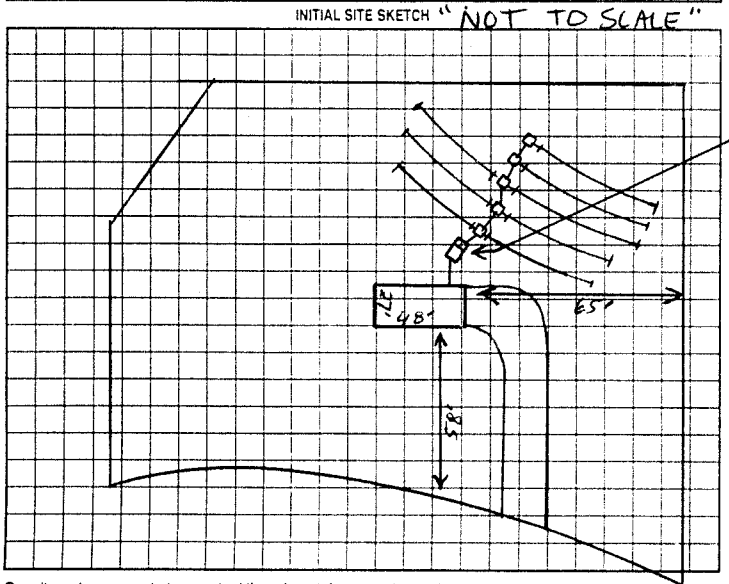

AS BUILT SKETCH

SEPIC TANK

① CUT OFF INLET PIPE, EXCESSIVE LENGTH INSIDE TANK.

⑤ OUTLET PIPE NEEDS DUG UP & A 45° ELBOW PLACED ON IT SO OUTLET PIPE IS NOT SO FAR UP (AGAINST LID).

③ CONSERVE H2O, CHEMICALS, & EVERYTHING ON "LIST" TO PREVENT FUTURE FAILURE, ESPECIALLY EXCESSIVE WASHING MACHINE USES.

④ SYSTEM IS DESIGNED FOR 480 GALLONS PER DAY. GET H2O DATA & COMPARE.

DENR FIGURES FOR H2O USAGE
5 PEOPLE X 60 gal/pr-/pr-sa-/day = 300 gals/day

Permit can be suspended or revoked if any false information is supplied toward securing the permit, any unauthorized changes are made to the site any unauthorized changes are made in the installation of the system. Improvement Permit with plat valid without expiration. Improvement Permit with site plan valid for sixty months. Authorization to Construct is valid for a period equal to that of Improvement Permit – not to exceed sixty months.

Signed: Talbot D Sullivan date

Improvement Permit by: date 03-15-02

Authorization to Construct by: date 03-15-02

Installed by DAVID PHISNER

Operation Permit by date 04-09-02

Existing System Inspection by date

HEALTH DEPT. COPY WHITE OWNER COPY (FINAL) YELLOW OWNER COPY (INITIAL) PINK