IREDELL COUNTY HEALTH DEPARTMENT

STATESVILLE 704-878-5305 (1) MOORESVILLE 704-664-5281

IMPROVEMENT PERMIT / AUTHORIZATION TO CONSTRUCT / OPERATION PERMIT / EXISTING SYSTEM INSPECTION

PERMIT# 119880 PIN# 4765-58-1687 DATE 4-27-04

OWNER OR CONTRACTOR BRIAN SPURRIER PHONE: Business 704-400-7019 Home 704-872-0179

ADDRESS 1270 NORTHSIDE DRIVE, STATESVILLE, NC 28625

LOCATION US 64 EAST TL RIVERHILL ROAD, TL RIVERGREEN DR TL SWEETWATER DRIVE, 5TH LOT ON LEFT

SUBDIVISION RIVERGREEN BLOCK / SECTION _____ LOT 5 LOT AREA 0.49 ACRE SITE CLASS. PS DESIGN FLOW 360 L.T.A.R. 0.30 GPD/FT²

Septic Tank: 1000 Gallons; STB 1012 Date 12-19-03
Pump Tank: _____ Gallons; PT _____ Date _____
Pump Make: _____ Model _____ Serial No. _____
Nitrification Field: No Fields 1 Square Feet EQ TO 1200 Linear Feet 200
No Lines FOUR Trench Width 24" Max Trench Bottom Depth 36" ~~Gravel~~ Depth SAND 24"

☑ New System ☐ Repair System Type: I, II, (III), IV, V, VI
System Description: 50% REDUCTION GRAVITY
Repair System Description: 50% REDUCTION, LOW-PRESS
Maintenance Agreement Required: ☐ Yes ☑ No

☐ House/Mod. Home ☑ Mobile Home ☐ Business ☐ Other
No. Bedrooms 3 No. Bathrooms 2 No. Employees ____


Water Supply: ☑ Individual ☐ Public ☐ Community

☐ Slab ☑ Crawl Space ☐ Basement w/plumbing ☐ Basement wo/plumbing


Comments:/Conditions: (1) REMOVE EXISTING FIELD TERRACE IN AREA OF DRAINFIELD TO PROVIDE UNIFORM SLOPE (2) USE THREE FLOW DIVIDER TEES TO ACHIEVE EQUAL DISTRIBUTION INTO FOUR LINES OF 12 PANELS EACH.

Comments:/Conditions: SEPTIC TANK WITH MARKER INSTALLED USING "TUF-TITE" FILTER UPPER LINES INSTALLED DEEP

INITIAL SITE SKETCH

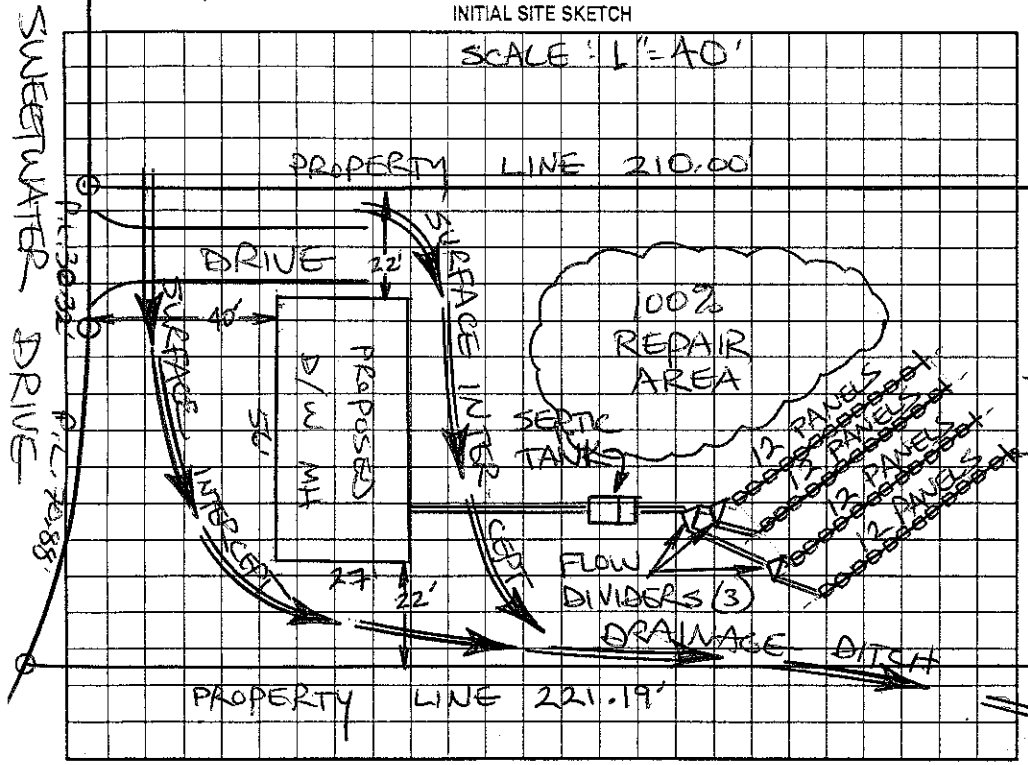

AS BUILT SKETCH

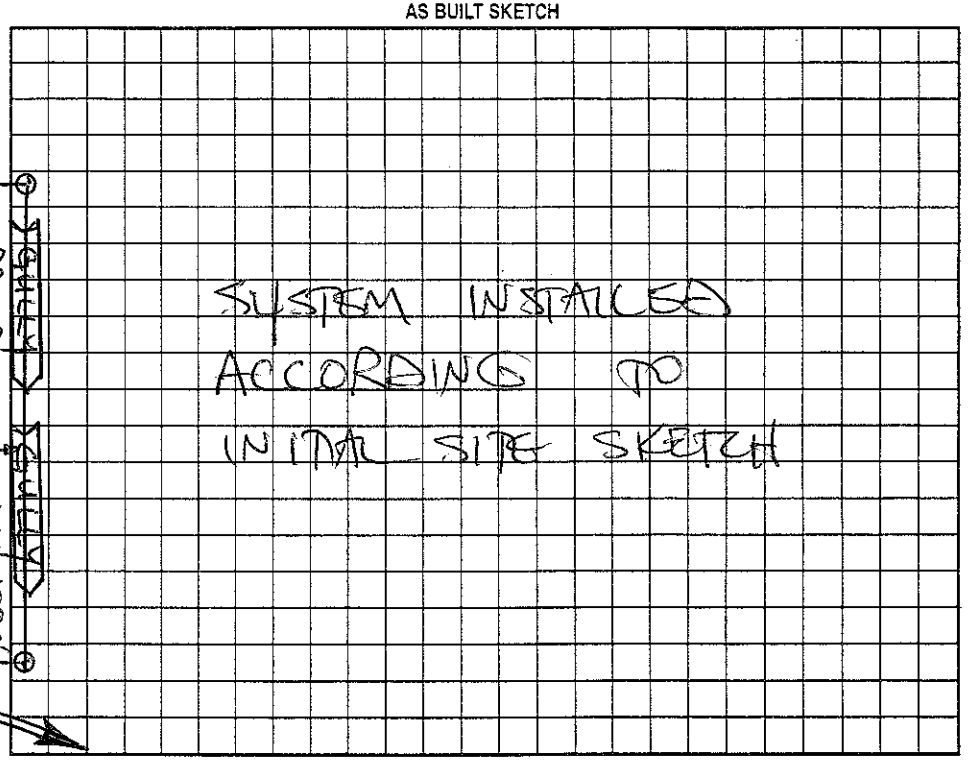

Permit can be suspended or revoked if any false information is supplied toward securing the permit/any unauthorized changes are made to the site/any unauthorized changes are made in the installation of the system. Improvement Permit with plat valid without expiration. Improvement Permit with site plan valid for sixty months. Authorization to Construct is valid for a period equal to that of Improvement Permit – not to exceed sixty months.

Signed: _____ date 4/30/04 Installed by: CRAIG THOMPSON

Improvement Permit by: STEVE HEDRICK date 4-27-04 Operation Permit by: STEVE HEDRICK date 5-27-04

Authorization to Construct by: STEVE HEDRICK date 4-27-04 Existing System Inspection by: _____ date _____

HEALTH DEPT. COPY: WHITE OWNER COPY (FINAL): YELLOW OWNER COPY (INITIAL): PINK