IREDELL COUNTY HEALTH DEPARTMENT

STATESVILLE 704-878-5305 MOORESVILLE 704-664-5281

IMPROVEMENT PERMIT / AUTHORIZATION TO CONSTRUCT / OPERATION PERMIT / EXISTING SYSTEM INSPECTION

PERMIT# 094951 PIN# 4765 58 0950 PT DATE 6-28-01

OWNER OR CONTRACTOR FLEETWOOD HOMES PHONE: Business 704-528-7120 Home

ADDRESS 1040 CHARLOTTE HWY, TROUTMAN, INC 28166

LOCATION HWY 64E, (A) RIVERHILL RD, (B) RIVERGREEN, (C) SWEETWATER, ON RT

SUBDIVISION RIVERGREEN BLOCK / SECTION LOT 17 LOT AREA 0.62 AC SITE CLASS 1S DESIGN FLOW 360 L.T.A.R. .3

Septic Tank: 1000 Gallons: STB 1012 Date 3-5-01

Pump Tank: Gallons: PT Date

Pump Make: Model Serial No.

Nitrification Field: No Fields 1 Square Feet EQ=1200 Linear Feet 300'

No Lines 3 Trench Width 36" Max Trench Bottom Depth 36"

[X] New System [ ] Repair System Type: I, II, (III) IV, V, VI

System Description: GRAY 25% REDUCT

Repair System Description: LP PANEL

Maintenance Agreement Required: [ ] Yes [X] No

[X] House/Mod. Home No. Bedrooms 5

[ ] Mobile Home No. Bathrooms 2

[ ] Business No. Employees

[ ] Other


Gravel Depth N/A [ ] Slab [X] Crawl Space [ ] Basement w/plumbing [ ] Basement wo/plumbing

Water Supply: [ ] Individual [X] Public [ ] Community


Comments/Conditions: (1) INSTALL LINES ON CONTOUR

Comments/Conditions: INSTALLED AS SHOWN WITH POLYLOK & MARKER

INITIAL SITE SKETCH 1"=50'

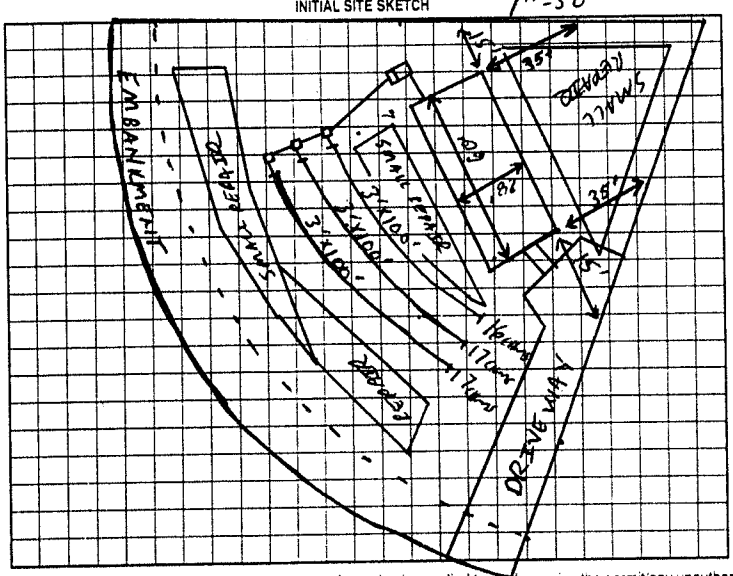

AS BUILT SKETCH

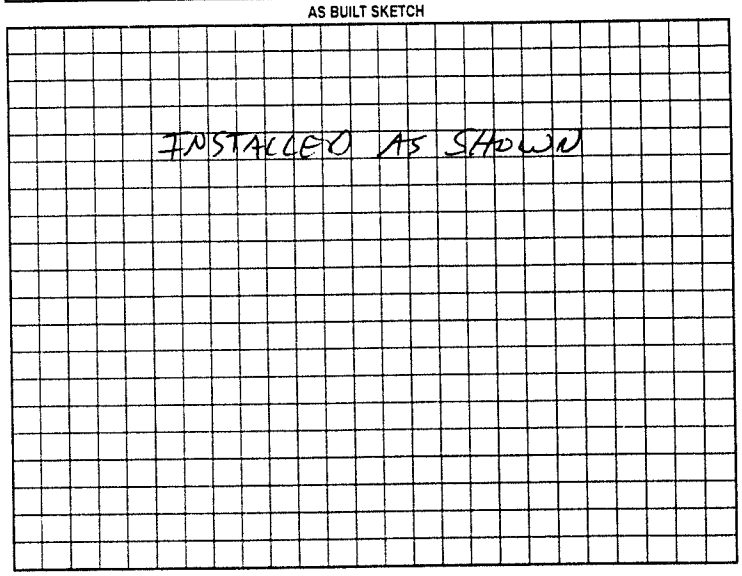

Permit can be suspended or revoked if any false information is supplied toward securing the permit/any unauthorized changes are made to the site/any unauthorized changes are made in the installation of the system. Improvement Permit with plat valid without expiration. Improvement Permit with site plan valid for sixty months. Authorization to Construct is valid for a period equal to that of Improvement Permit – not to exceed sixty months.

Signed: Dennis Dalley date 6/28/01 Installed by: A-1 BACKHOE

Improvement Permit by: Jim Cook REHS date 6-28-01 Operation Permit by: Jim Cook REHS date 6-28-01

Authorization to Construct by: Jim Cook REHS date 6-28-01 Existing System Inspection by: date

HEALTH DEPT COPY: WHITE OWNER COPY (FINAL) YELLOW OWNER COPY (INITIAL) PINK