IREDELL COUNTY HEALTH DEPARTMENT

STATESVILLE 704-878-5305 MOORESVILLE 704-664-5281

IMPROVEMENT PERMIT / AUTHORIZATION TO CONSTRUCT / OPERATION PERMIT / EXISTING SYSTEM INSPECTION

PERMIT# [redacted]106871 PIN# 4765-58-[redacted]2686 DATE 09-10-02

OWNER OR CONTRACTOR FLEETWOOD HOMES PHONE: Business 704-872-0179 Home

ADDRESS 1270 NORTHSIDE DR STATESVILLE NC 28677

LOCATION 64 EAST, (L) RIVERHILL, (L) RIVERGREEN, (L) SWEETWATER, LOT 4 ON LEFT

SUBDIVISION RIVERGREEN BLOCK / SECTION LOT 4 LOT AREA .4831 SITE CLASS PS DESIGN FLOW 360 L.T.A.R. .3

Septic Tank: 1000 Gallons; STB 1007 Date 12-14-02
Pump Tank: 1000 Gallons; PT 274 Date 10-7-02
Pump Make: ZOELLER Model N152-A Serial No. 152-0007
Nitrification Field: No Fields / Square Feet EQ=120V' Linear Feet 200'
No Lines 5 X 40' Trench Width 24" Max Trench Bottom Depth 36" Gravel Depth N/A

[X] New System [ ] Repair System Type: I, II, (III) IV, V, VI
System Description: PUMP 500 120
Repair System Description: LP PAVER
Maintenance Agreement Required: [ ] Yes [X] No

[ ] House/Mod. Home [X] Mobile Home [ ] Business [ ] Other
No. Bedrooms 3 No. Bathrooms 2 No. Employees


Water Supply: [ ] Individual [X] Public [ ] Community

[ ] Slab [X] Crawl Space [ ] Basement w/plumbing [ ] Basement wo/plumbing

Comments/Conditions: (1) MAINTAIN SETBACK, ESPECIALLY DITCH TANKS SETBACKS (2) SYSTEM & HOUSE IS FLAGGED OUT ENTIRELY (3) CALL PRIOR TO INSTALLATION FOR PUMP SIZING. (4) PAD MUST BE FILLED & NOT CUT (5) USE PRESSURE MANIFOLD (6) GRADE OUT OLD FIELD TERRACE INSTALLED DURING WET SOIL CONDITIONS.

DOUYLOK FILTER & MARKER. V'D LINES & TANKS LE 03-04-03, V'D ELECTRICAL & PRESSURE. EVERYTHING OK. LL

INITIAL SITE SKETCH 1" ≈ 50'

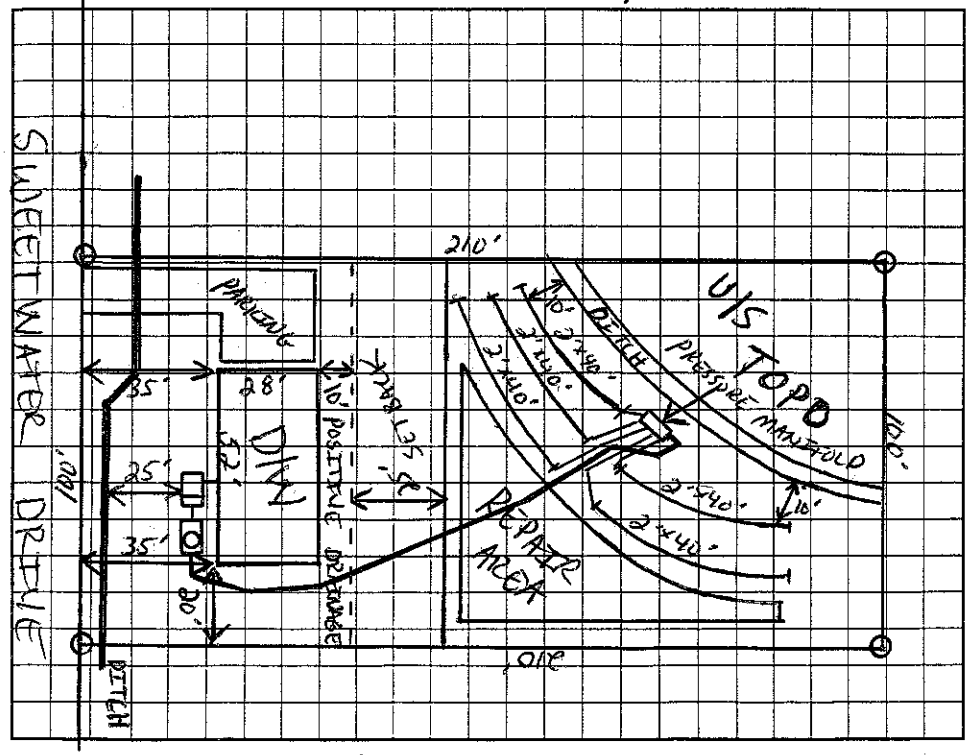

AS BUILT SKETCH

Permit can be suspended or revoked if any false information is supplied toward securing the permit/any unauthorized changes are made to the site/any unauthorized changes are made in the installation of the system. Improvement Permit with plat valid without expiration. Improvement Permit with site plan valid for sixty months. Authorization to Construct is valid for a period equal to that of Improvement Permit – not to exceed sixty months.

Signed: [signature] date 12/18/02 Installed by: JAMES HUDDLER

Improvement Permit by: [signature] RS date 09-10-02 Operation Permit by: [signature] RS date 03-26-03

Authorization to Construct by: [signature] RS date 09-10-02 Existing System Inspection by: date

HEALTH DEPT. COPY: WHITE OWNER COPY (FINAL): YELLOW OWNER COPY (INITIAL): PINK