IREDELL COUNTY HEALTH DEPARTMENT

STATESVILLE 704-878-5305 MOORESVILLE 704-664-5281

IMPROVEMENT PERMIT / AUTHORIZATION TO CONSTRUCT / OPERATION PERMIT / EXISTING SYSTEM INSPECTION

PERMIT# 104899 PIN# 4765-58-2961

OWNER OR CONTRACTOR FLEETWOOD HOMES PHONE: Business 704-872-0179 RENEE Home DATE 03-27-02

ADDRESS 1270 NORTHSIDE DR STATESVILLE NC 28625

LOCATION 64 E @ RIVERHILL (E) RIVERGREEN, @ SWEETWATER, LOT # 18 ON RT

SUBDIVISION RIVERGREEN BLOCK / SECTION LOT 18 LOT AREA .46 SITE CLASS PS DESIGN FLOW 360 L.T.A.R. 13

Septic Tank: 1000 Gallons: STB 794 Date 3-28-02
Pump Tank: Gallons: PT Date
Pump Make: Model Serial No.
Nitrification Field: No Fields 1 Square Feet EQ=1200' Linear Feet 300'
No Lines 3 Trench Width 36" Max Trench Bottom Depth 36"

X New System ☐ Repair System Type: I II (III) IV V VI
System Description: 6 DAY 75% RED
Repair System Description: LP PANEL
Maintenance Agreement Required: ☐ Yes X No
Gravel Depth N/A ☐ Slab X Crawl Space ☐ Basement w/plumbing ☐ Basement wo/plumbing


☐ House/Mod. Home No. Bedrooms 3
X Mobile Home D/W No. Bathrooms 2
☐ Business No. Employees
☐ Other

Water Supply: ☐ Individual X Public ☐ Community

Comments/Conditions: (1) KEEP H2O LINE 10' FROM ANY PART OF SYSTEM (2) MAINTAIN SETBACKS (3) INSTALL LINES ON CONTOURS

Comments/Conditions DATE, FILTER FIXED, -7 FIXED
ZABEL FILTER & MARKER

INITIAL SITE SKETCH 1"=40'

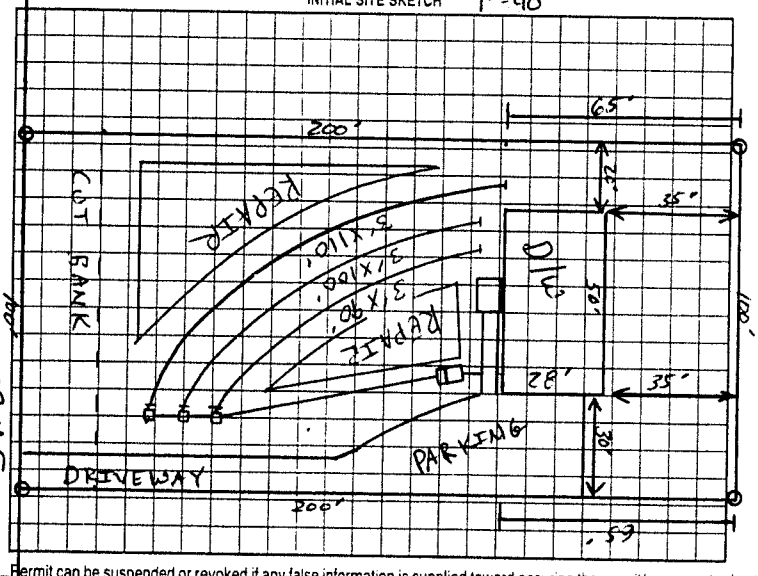

SWEET WATER

AS BUILT SKETCH

SYSTEM INSTALLED 15' OFF TOP OF CUT
DO NOT CUT UP MORE DURING LANDSCAPING,
EXCESSIVE CUTTING MAY CAUSE FAILURE.

Permit can be suspended or revoked if any false information is supplied toward securing the permit/any unauthorized changes are made to the site/any unauthorized changes are made in the installation of the system. Improvement Permit with plan valid without expiration. Improvement Permit with site plan valid for sixty months. Authorization to Construct is valid for a period equal to that of Improvement Permit – not to exceed sixty months.

Signed: date

Improvement Permit by: date 03-27-02

Authorization to Construct by: date 03-27-02

Installed by: CRAIG THOMPSON

Operation Permit by: date 05-14-02

Existing System Inspection by: date

HEALTH DEPT. COPY WHITE OWNER COPY (FINAL) YELLOW OWNER COPY (INITIAL) PINK