336-751-1923
BILL MARTIN

IREDELL COUNTY HEALTH DEPARTMENT

STATESVILLE 704-878-5305 MOORESVILLE 704-664-5281

IMPROVEMENT PERMIT / AUTHORIZATION TO CONSTRUCT / OPERATION PERMIT / EXISTING SYSTEM INSPECTION

PERMIT# 104052 PIN# 4765-58-3686 DATE 03-27-02

OWNER OR CONTRACTOR FLEETWOOD HOMES PHONE: Business 704-872-0179 Home

ADDRESS 111 SWEETWATER DR STATESVILLE NC 28625

LOCATION 64 E, ① RIVERHILL, ② RIVERGREEN ③ SWEETWATER, LOT #3 ON LFT

SUBDIVISION RIVERGREEN BLOCK / SECTION LOT 3 LOT AREA .48AC SITE CLASS PS DESIGN FLOW 360 L.T.A.R. .3

Septic Tank: 1000 Gallons, STB 1012 Date 02-28-02
Pump Tank: 1000 Gallons, PT 17 Date 4-15-02
Pump Make: MYERS Model NW50-1HP Serial No 880548
Nitrification Field: No Fields 1 Square Feet EQ=1200' Linear Feet 300'
No Lines 4X75' Trench Width 36" Max Trench Bottom Depth 36" Gravel Depth N/A

X New System ☐ Repair System Type: I. II III IV. V. VI
System Description: PUMP 25% REDUCT
Repair System Description: CP PANEL
Maintenance Agreement Required: ☐ Yes X No

X House/Mod. Home No. Bedrooms 3
☐ Mobile Home No. Bathrooms 2
☐ Business No. Employees
☐ Other


☐ Slab X Crawl Space ☐ Basement w/plumbing ☐ Basement wo/plumbing

Water Supply: ☐ Individual X Public ☐ Community

Comments/Conditions: ① DO NOT CUT PAD → WILL VOID PERMIT ② CALL PRIOR TO INSTALLATION FOR PUMP SIZING ③ INSTALL LINES ON CONTOURS ④ MAINTAIN SETBACKS ⑤ USE PRESSURE MANIFOLD

Comments/Conditions: CHECKED LINES ON 6-25-02 / TURN DOWN DUE TO EXCESSIVE RISE IN EACH LINE. MUST REGRADE. RAINED OFF AND ON ALL DAY ON 6-26-02 LL

INITIAL SITE SKETCH 1"=40'

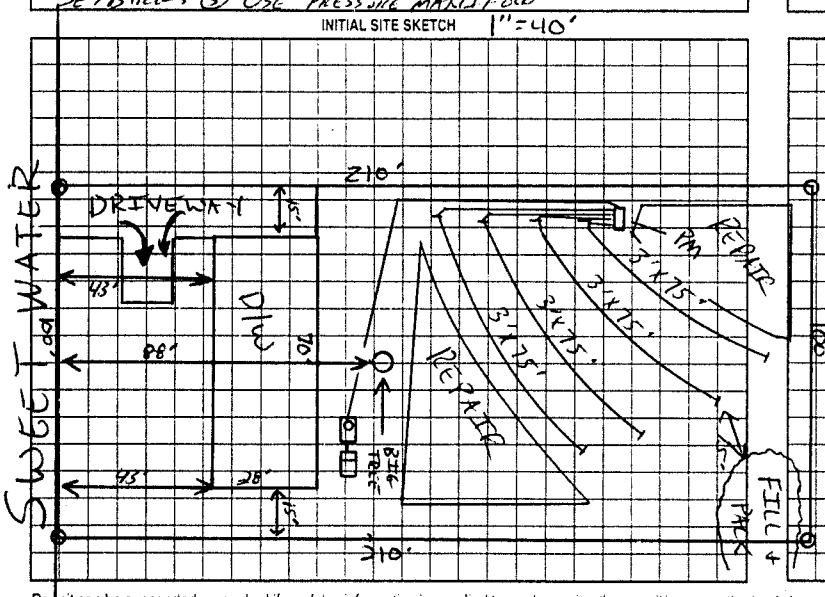

AS BUILT SKETCH

POLYLOK FILTER & MARKED
SET PRESSURE & ELEVATION
LP with Generator,

SYSTEM INSTALLED DURING WET CONDITIONS, LET DRY OUT & FIXED RISE. EVERYTHING OK BY STATE RULES. LL 07-02-02

Permit can be suspended or revoked if any false information is supplied toward securing the permit/any unauthorized changes are made to the site/any unauthorized changes are made in the installation of the system. Improvement Permit with plat valid without expiration. Improvement Permit with site plan valid for sixty months. Authorization to Construct is valid for a period equal to that of Improvement Permit – not to exceed sixty months.

Signed: _____ date _____

Improvement Permit by: _____ date 03-27-02

Authorization to Construct by: _____ date 03-27-02

Installed by: CRAIG THOMPSON

Operation Permit by: _____ date 07-2-02

Existing System Inspection by: _____ date _____

HEALTH DEPT COPY WHITE OWNER COPY (FINAL) YELLOW OWNER COPY (INITIAL) PINK