IREDELL COUNTY HEALTH DEPARTMENT

STATESVILLE 704-878-5305 MOORESVILLE 704-664-5281

IMPROVEMENT PERMIT / AUTHORIZATION TO CONSTRUCT / OPERATION PERMIT / EXISTING SYSTEM INSPECTION

PERMIT# 094892 PIN# 4765 58 0950 PT DATE 03-29-01

OWNER OR CONTRACTOR FLEETWOOD HOMES PHONE: Business 704-528-7120 Home

ADDRESS 1040 CHARLOTTE HWY, TROUTMAN, NC 28166

LOCATION HWY 64E, (L) RIVERCHASE (L) RIVERGLEEN, (L) SWEETWATER ON RIGHT

SUBDIVISION RIVERGLEEN BLOCK / SECTION LOT 19 LOT AREA 0.45 SITE CLASS PS DESIGN FLOW 360 L.T.A.R. .3

Septic Tank: 1000 Gallons; STB 312 Date 10-18-99
Pump Tank: Gallons; PT Date
Pump Make: Model Serial No.
Nitrification Field: No Fields 1 Square Feet EQ to 1200' Linear Feet 200'
No Lines 6 Trench Width 34" Max Trench Bottom Depth 36"


[X] New System [ ] Repair System Type: I. II. (III) IV. V. VI
System Description: GRAV PANEL
Repair System Description: LPP/PUMP PANEL
Maintenance Agreement Required: [ ] Yes [X] No
Gravel Depth N/A [ ] Slab [X] Crawl Space [ ] Basement w/plumbing [ ] Basement wo/plumbing

[ ] House/Mod. Home No. Bedrooms 3
[X] Mobile Home No. Bathrooms 2
[ ] Business No. Employees
[ ] Other

Water Supply: [ ] Individual [X] Public [ ] Community

Comments/Conditions: (1) INSTALL LINES ON CONTOUR & USE 42 PANELS (2) Use 2 Dist Boxes with Speed levelers & one Flow Divider Tee (3) KEEP H2O Line 10' From System (4) System is TIGHT, HAVE ANY P's CALL!

INITIAL SITE SKETCH 1" = 50'

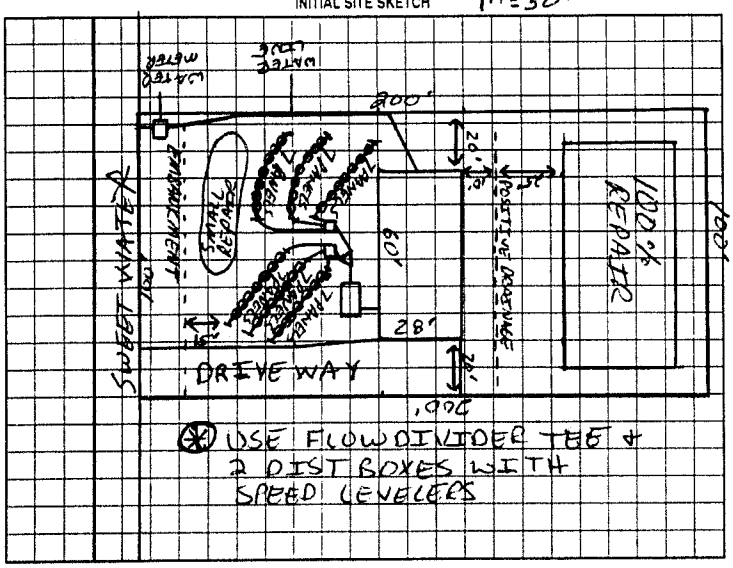


(4) USE FLOW DIVIDER TEE & 2 DIST BOXES WITH SPEED LEVELERS

Comments/Conditions: (5) DONOT BUILD FRONT PORCH OVER SYSTEM

INSTALLED AS SHOWN WITH POLYFLOW FILTER & MARKER

AS BUILT SKETCH

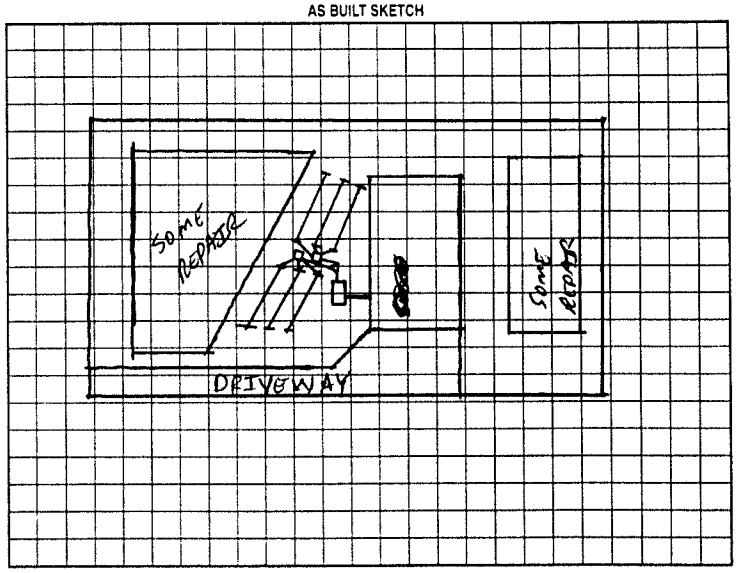

Permit can be suspended or revoked if any false information is supplied toward securing the permit/any unauthorized changes are made to the site/any unauthorized changes are made in the installation of the system. Improvement Permit with plat valid without expiration. Improvement Permit with site plan valid for sixty months. Authorization to Construct is valid for a period equal to that of Improvement Permit – not to exceed sixty months.

Signed: Daniel Queen date 04-3-01 Installed by: CRAIG THOMPSON

Improvement Permit by: Jim Cook REHS date 03-29-01 Operation Permit by: Jim Cook REHS date 6-29-01

Authorization to Construct by: Jim Cook REHS date 03-29-01 Existing System Inspection by: date

HEALTH DEPT. COPY WHITE OWNER COPY (FINAL) YELLOW OWNER COPY (INITIAL) PINK