IREDELL COUNTY HEALTH DEPARTMENT

STATESVILLE 704-878-5305 MOORESVILLE 704-664-5281

IMPROVEMENT PERMIT / AUTHORIZATION TO CONSTRUCT / OPERATION PERMIT / EXISTING SYSTEM INSPECTION

PERMIT# 094893 PIN# 4765 58 0950 PT DATE 3-30-01

OWNER OR CONTRACTOR FLEETWOOD HOMES PHONE: Business 704-528-7120 Home

ADDRESS [redacted] 1040 CHARLOTTE HWY TROUTMAN NC 28166

LOCATION HWY 64 E, (R) RIVERHILL, (L) RIVERGREEN, (R) SWEETWATER, ON RIGHT

SUBDIVISION RIVERGREEN BLOCK / SECTION LOT 20 LOT AREA 0.45 SITE CLASS PS DESIGN FLOW 360 L.T.A.R. 1.3

Septic Tank: 1000 Gallons: STB 312 Date 12-17-99
Pump Tank: Gallons: PT Date
Pump Make: Model Serial No.
Nitrification Field: No Fields 1 Square Feet EQ=1200 Linear Feet 200
No Lines 6 Trench Width 24" Max Trench Bottom Depth 36"

X New System ☐ Repair System Type: I, II, (III), IV, V, VI
System Description: GRAV PANEL
Repair System Description: LPP/RIMLINE PANEL
Maintenance Agreement Required: ☐ Yes X No

☐ House/Mod Home No. Bedrooms 3
X Mobile Home No. Bathrooms 2
☐ Business No. Employees
☐ Other


Water Supply: ☐ Individual X Public ☐ Community

☐ Slab X Crawl Space ☐ Basement w/plumbing ☐ Basement wo/plumbing

Comments/Conditions: (1) INSTALL LINES ON CONTOUR (2) KEEP SYSTEM 5' off house & 10' off property line, (3) KEEP H2O Line 10' away from system

Comments/Conditions: SYSTEM INSTALLED AS SHOWN WITH POLYLOK FILTER & MARKER
DO NOT BUILD PORCH OVER SYSTEM

INITIAL SITE SKETCH

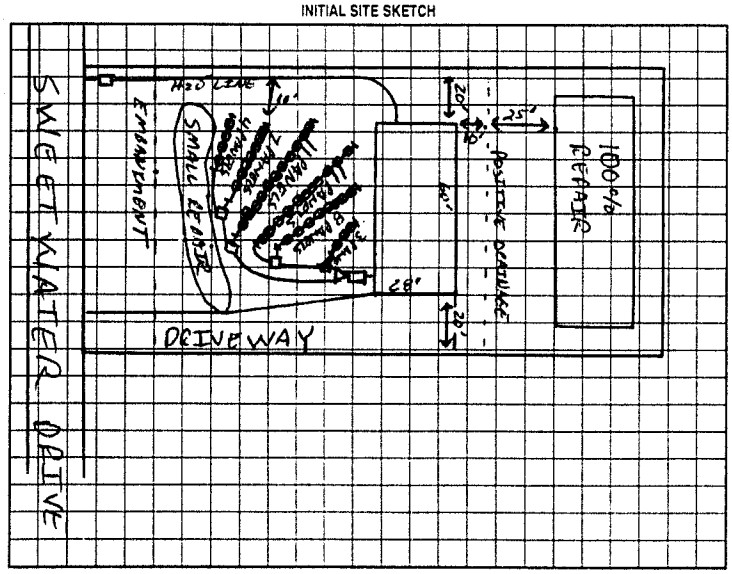

AS BUILT SKETCH

INSTALLED AS SHOWN

Permit can be suspended or revoked if any false information is supplied toward securing the permit/any unauthorized changes are made to the site/any unauthorized changes are made in the installation of the system. Improvement Permit with plat valid without expiration. Improvement Permit with site plan valid for sixty months. Authorization to Construct is valid for a period equal to that of Improvement Permit – not to exceed sixty months.

Signed: [signature] date

Improvement Permit by: [signature] RSI date 03-30-01

Authorization to Construct by: [signature] RSI date 03-30-01

Installed by: CRAIG THOMPSON

Operation Permit by: [signature] RSI date 6-29-01

Existing System Inspection by: date

HEALTH DEPT COPY WHITE OWNER COPY (FINAL) YELLOW OWNER COPY (INITIAL) PINK