THIS PERMIT REPLACES PREVIOUSLY ISSUED PERMIT ON 4-3-01

IREDELL COUNTY HEALTH DEPARTMENT

STATESVILLE 704-878-5305 MOORESVILLE 704-664-5281

IMPROVEMENT PERMIT / AUTHORIZATION TO CONSTRUCT / OPERATION PERMIT / EXISTING SYSTEM INSPECTION

PERMIT# 094894 PIN# 4765 58 ~~0956 PT~~ 5990 DATE 5-18-01

OWNER OR CONTRACTOR FLEETWOOD HUMES PHONE: Business 704-528-7120 Home

ADDRESS 1040 CHARLOTTE HWY TROUTMAN, NC 28166

LOCATION HWY 64E, ① RIVERHILL, ① RIVERGREEN, ON LEFT

SUBDIVISION RIVERGREEN BLOCK / SECTION LOT 21 LOT AREA .46 SITE CLASS. PS DESIGN FLOW 360 L.T.A.R. .3

Septic Tank: 1000 Gallons; STB 1012 Date 7-8-01
Pump Tank: Gallons; PT Date
Pump Make: Model Serial No.
Nitrification Field: No Fields 1 Square Feet EQ = 1200 Linear Feet 300'
No Lines 4 Trench Width 36" Max Trench Bottom Depth 36" Gravel Depth N/A

☒ New System ☐ Repair System Type: I, II, (III) IV, V, VI
System Description: 25% RED
Repair System Description: 50% RED
Maintenance Agreement Required: ☐ Yes ☒ No


☐ House/Mod. Home No. Bedrooms 3
☒ Mobile Home DW No. Bathrooms 2
☐ Business No. Employees
☐ Other
☐ Slab ☒ Crawl Space ☐ Basement w/plumbing ☐ Basement wo/plumbing

Water Supply: ☐ Individual ☒ Public ☐ Community


Comments:/Conditions: ① INSTALL LINES ON CONTOUR ② MAINTAIN SETBACKS ③ USE FOUL DROP BOXES + 25% REDUCTION SYSTEM ④ KEEP TANK HIGH ENOUGH TO GET FALL TO SYSTEM

Comments:/Conditions: POLY LOK FILTER & MARKER INSTALLED AS SHOWN

INITIAL SITE SKETCH

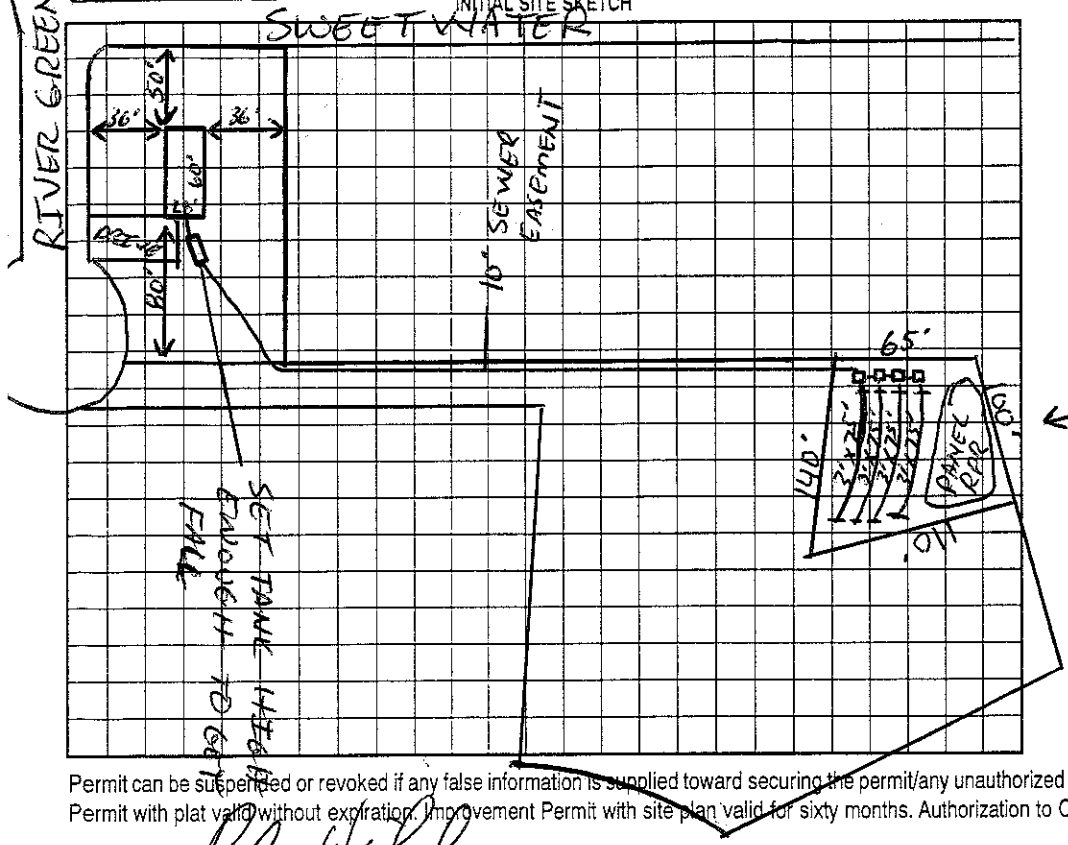

AS BUILT SKETCH

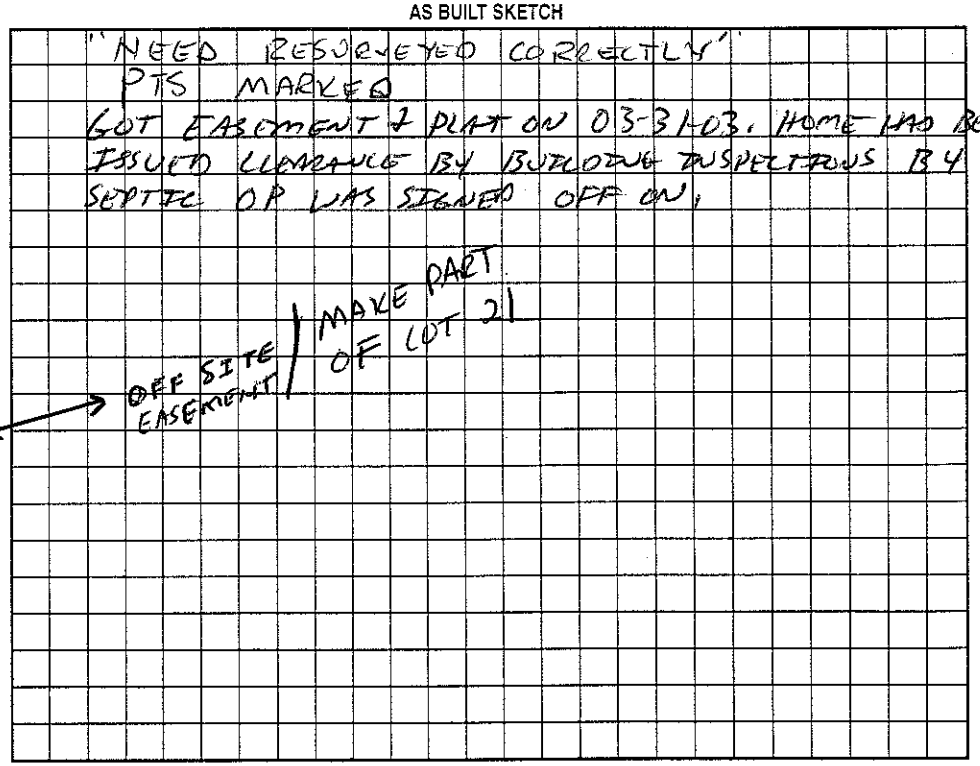

Permit can be suspended or revoked if any false information is supplied toward securing the permit/any unauthorized changes are made to the site/any unauthorized changes are made in the installation of the system. Improvement Permit with plat valid without expiration. Improvement Permit with site plan valid for sixty months. Authorization to Construct is valid for a period equal to that of Improvement Permit – not to exceed sixty months.

Signed: date

Improvement Permit by: date 5-18-01

Authorization to Construct by: date 5-18-01

Installed by: A-1 BACKHOE

Operation Permit by: date 03-31-03

Existing System Inspection by: date

HEALTH DEPT. COPY: WHITE OWNER COPY (FINAL): YELLOW OWNER COPY (INITIAL): PINK