IREDELL COUNTY HEALTH DEPARTMENT

STATESVILLE 704-878-5305 MOORESVILLE 704-664-5281

IMPROVEMENT PERMIT / AUTHORIZATION TO CONSTRUCT / OPERATION PERMIT / EXISTING SYSTEM INSPECTION

PERMIT# 09419 PIN# 4765 58 0950 DATE 2/23/01

OWNER OR CONTRACTOR Piedmont Realty PHONE. Business (704) 872-0179 Home

ADDRESS 5551 Monroe Road Charlotte N.C 28212

LOCATION 64 East, ② Riverhill Rd, ③ Evergreen on Right

SUBDIVISION Rivergreen BLOCK / SECTION — LOT 27 LOT AREA .45 SITE CLASS PS DESIGN FLOW 360 L.T.A.R. .3

Septic Tank: 1,000 Gallons: STB N/A Date 11-10-00
Pump Tank: Gallons: PT Date
Pump Make: Model Serial No.
Nitrification Field: No Fields 1 Square Feet 1200 Ft Linear Feet 300
No Lines Five@60' Trench Width 36" Max Trench Bottom Depth 36" Gravel Depth —

☒ New System ☐ Repair System Type: I, II, (III), IV, V
System Description: 25% Reduction Gravity
Repair System Description: 50% Reduction, Pump
Maintenance Agreement Required: ☐ Yes ☒ No


☒ House/Mod. Home No. Bedrooms 3
☐ Mobile Home No. Bathrooms 2
☐ Business No. Employees
☐ Other
☐ Slab ☒ Crawl Space ☐ Basement w/plumbing ☐ Basement wo/plumbing

Water Supply: ☐ Individual ☒ Public ☐ Community

Comments:/Conditions: ① Do not install when wet ② Use 25% reduction system either HDPE sections or Chambers w/Control ③ Keep lines 10 ft from property lines ④ Keep Tank 5 ft From Structure ⑤ Use Two (2) Distribution boxes.

Comments:/Conditions: INSTALLED WITH MACKER & ROCK WRAP FILTER

INITIAL SITE SKETCH 1"=40'

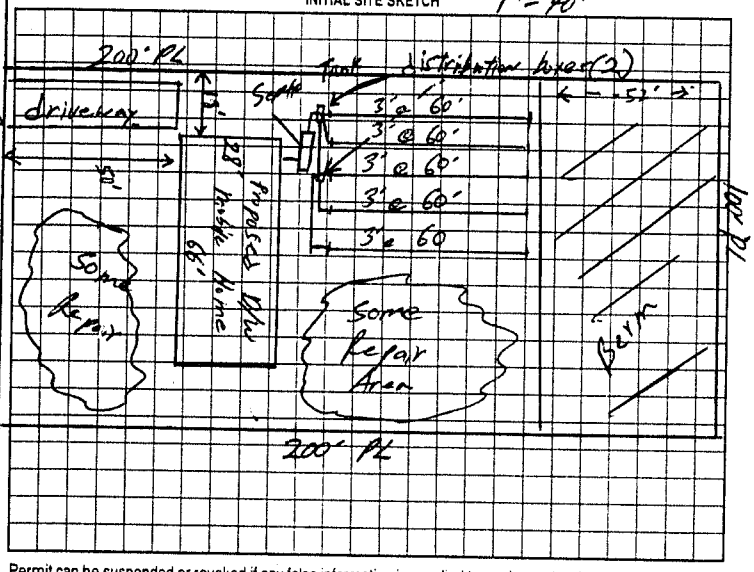

AS BUILT SKETCH

Permit can be suspended or revoked if any false information is supplied toward securing the permit/any unauthorized changes are made to the site/any unauthorized changes are made in the installation of the system. Improvement Permit with plat valid without expiration. Improvement Permit with site plan valid for sixty months. Authorization to Construct is valid for a period equal to that of Improvement Permit – not to exceed sixty months.

Signed: Steve Pope date 2-23-01

Improvement Permit by: William O. Johnson RSI date 2/23/01

Authorization to Construct by: William O. Johnson RSI date 2/23/01

Installed by: A-1 BACK HOE

Operation Permit by: Jane Cook RSI date 07-27-01

Existing System Inspection by: date

HEALTH DEPT. COPY. WHITE OWNER COPY (FINAL). YELLOW OWNER COPY (INITIAL). PINK