IREDELL COUNTY HEALTH DEPARTMENT

Statesville Phone TR 3-7271 Mooresville Phone NO 3-1271

PERMIT TO INSTALL SEPTIC TANK

Permit No. 115 Permit Date 1-12 1971

Owner WILLIAM H ELLIS Address RT 1. STATESVILLE, NC.

Installed By ADAMS SEPTIC TANK SERVICE Address TAYLORSVILLE, NC


Location of Property RIVER HILL ROAD - 1ST HOUSE PAST EAST IREDELL LIONS CLUB Bldg.

Tank		Capacity		Length of Lines		Fixtures	
Block	( )	1000	(✓)	225'	(✓)	No. of Baths	(✓)
Precast	(✓)	1250	( )	250'	( )	Dishwasher	( )
		1500	( )	Other		Garbage Grdr.	( )
		Other				Other	

NOTIFY HEALTH DEPARTMENT AT LEAST EIGHT HOURS BEFORE TANK IS TO BE INSPECTED.

Final Inspection 1-12 1971 Approved Not Checked Disapproved ( )

Remarks

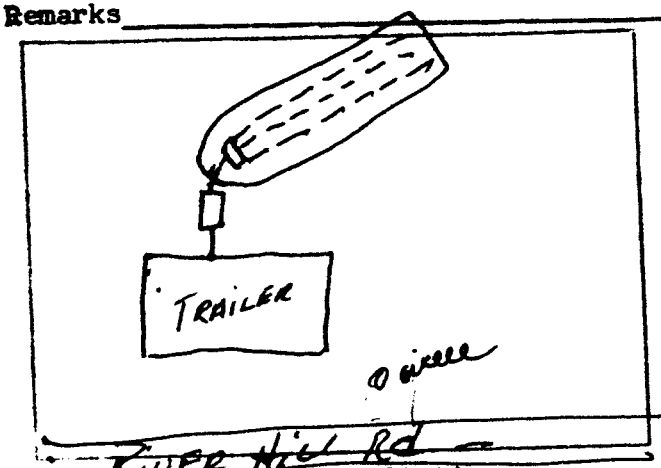

Sketch of Installation

Not Checked

Sanitarian