# IREDELL COUNTY HEALTH DEPARTMENT

STATESVILLE 704-878-5305 MOORESVILLE 704-664-5281

## IMPROVEMENT PERMIT / AUTHORIZATION TO CONSTRUCT / OPERATION PERMIT / EXISTING SYSTEM INSPECTION

PERMIT# 104573 PIN# 4765-59-1023 DATE 04-03-02

OWNER OR CONTRACTOR FLEETWOOD HOMES PHONE: Business 704-528-7120 TERRY Home

ADDRESS 1270 NORTHSIDE DR, STATESVILLE NC 28625

LOCATION 64E, ① RIVERHILL, ① RIVERGREEN, ② SWEETWATER, ON RT LOT #16

SUBDIVISION RIVERGREEN BLOCK / SECTION LOT 16 LOT AREA 0.5 AC SITE CLASS. PS DESIGN FLOW 360 L.T.A.R. 1.3

Septic Tank: 1000 Gallons; STB 1017 Date 1-30-02
Pump Tank: Gallons; PT Date
Pump Make: Model Serial No.
Nitrification Field: No Fields 1 Square Feet EQ×1200' Linear Feet 300'
No Lines 4X75' Trench Width 36" Max Trench Bottom Depth 36" Gravel Depth N/A

☒ New System ☐ Repair System Type: I, II, (III), IV, V, VI
System Description: GRAV 25% RED
Repair System Description: LP PANEL
Maintenance Agreement Required: ☐ Yes ☒ No

☐ House/Mod. Home No. Bedrooms 3
☒ Mobile Home DW No. Bathrooms 2
☐ Business No. Employees
☐ Other


☐ Slab ☒ Crawl Space ☐ Basement w/plumbing ☐ Basement wo/plumbing

Water Supply: ☐ Individual ☒ Public ☐ Community

Comments/Conditions: ① MAINTAIN SETBACKS ② GRADE OUT TERRACE ③ KEEP H2O LINE 10' FROM ANY PART OF SYSTEM ④ CONTOURS MAY CHANGE AFTER GRADING ⑤ INSTALL


Comments/Conditions: LINES ON LOW TOUR
TUFF TITE FICTER & MARKER
⑥ DONOT SIGN OFF ON OP UNTIL NEW H2O LINE IS INSTALLED & WE SEE SETBACKS ARE MET. RC V'D OK. LC 03-28-03

INITIAL SITE SKETCH 1"=40'

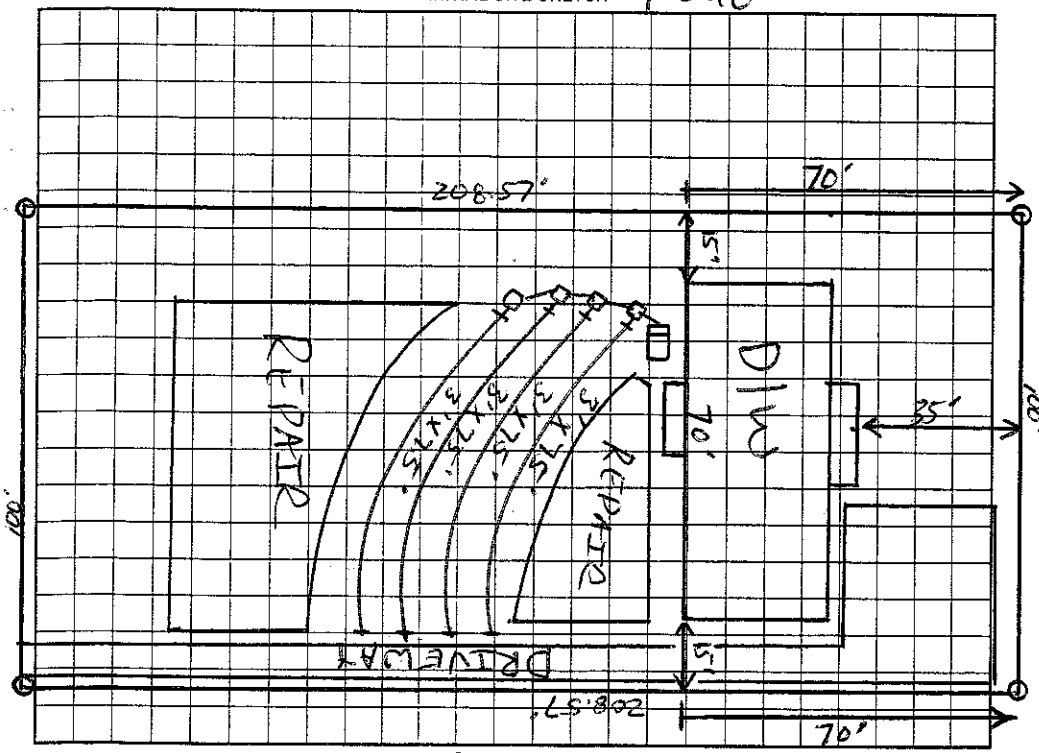


AS BUILT SKETCH

⑥ H2O LINE INSTALLED AT ENDS OF PRELIMINARIES, MADE THEM TAKE OUT & PACK BACK.
LINES HAD FALL BUT DID NOT EXCEED 1/4" per 10'.
BOX # 4 WAS DROP BOX BUT USED SPEED LEVELER AND USED AS A DIST BOX.

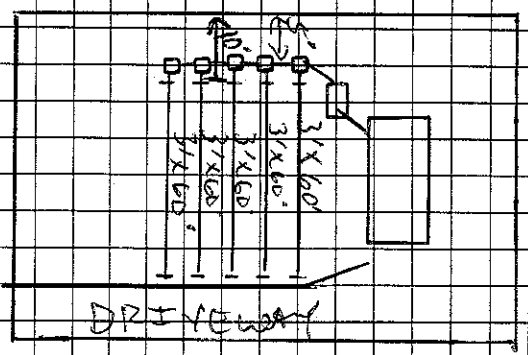


Permit can be suspended or revoked if any false information is supplied toward securing the permit/any unauthorized changes are made to the site/any unauthorized changes are made in the installation of the system. Improvement Permit with plat valid without expiration. Improvement Permit with site plan valid for sixty months. Authorization to Construct is valid for a period equal to that of Improvement Permit – not to exceed sixty months.

Signed: date 12/16/02 Installed by: CRAIG THOMPSON

Improvement Permit by: date 04-03-02 Operation Permit by: date 03-28-03

Authorization to Construct by: date 04-03-02 Existing System Inspection by: date

HEALTH DEPT. COPY: WHITE OWNER COPY (FINAL): YELLOW OWNER COPY (INITIAL): PINK