IREDELL COUNTY HEALTH DEPARTMENT

STATESVILLE 704-878-5305 CI MOORESVILLE 704-664-5281

IMPROVEMENT PERMIT / AUTHORIZATION TO CONSTRUCT / OPERATION PERMIT / EXISTING SYSTEM INSPECTION

PERMIT# 111649 PIN# 4765-59-3123 DATE 04-04-03

OWNER OR CONTRACTOR FLEETWOOD HOMES OF STATESVILLE PHONE: Business 704-872-0179 Home

ADDRESS 1220 NORTHSIDE DR STATESVILLE, NC 28677

LOCATION 64 EAST, (L) RIVERHILL RD, (L) RIVERGREEN, ON (LEFT IN) CUL-DE-SAC

SUBDIVISION RIVERGREEN BLOCK / SECTION LOT 22 LOT AREA 1.2438 SITE CLASS PS DESIGN FLOW 360 L.T.A.R. .13

Septic Tank: 1000 Gallons: STB 1012 Date 8-2467

Pump Tank: Gallons: PT Date

Pump Make: Model Serial No.

Nitrification Field: No Fields 1 Square Feet EQUIV Linear Feet 300'

No Lines 3x100' Trench Width 36" Max Trench Bottom Depth 36" Gravel Depth N/A

☒ New System ☐ Repair System Type: I, II, (III) IV, V, VI

System Description: GRAV @ 2541 RED

Repair System Description: LP PANEL

Maintenance Agreement Required: ☐ Yes ☒ No

☐ House/Mod. Home No. Bedrooms 3

☒ Mobile Home No. Bathrooms 2

☐ Business No. Employees

☐ Other

☐ Slab ☒ Crawl Space ☐ Basement w/plumbing ☐ Basement wo/plumbing

Water Supply: ☐ Individual ☒ Public ☐ Community


Comments/Conditions: (1) INSTALL LINES ON CONTOURS (2) MAINTAIN SETBACKS (3) SEPTIC LINES FLAGGED WT & WHITE & BLUE, (4) TANKS LOT HAS AN OFF SITE EASEMENT ON PROPERTY, (5) KEEP DRIVEWAY.

Comments/Conditions: OFF 10' SUPPLY EASEMENT


TUFF TITE FILTER & MANIFOLD, EZ FLOW INSTALLED AS DRAWN, HOUSE/D/W NOT SET UP @ time of Insp

"NOT TO SCALE"

INITIAL SITE SKETCH

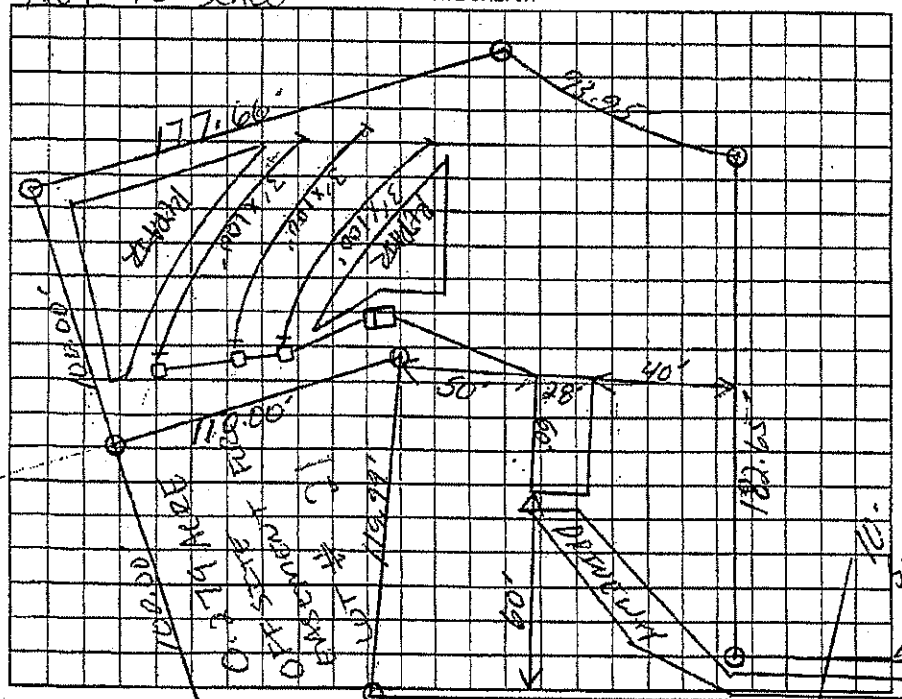

AS BUILT SKETCH

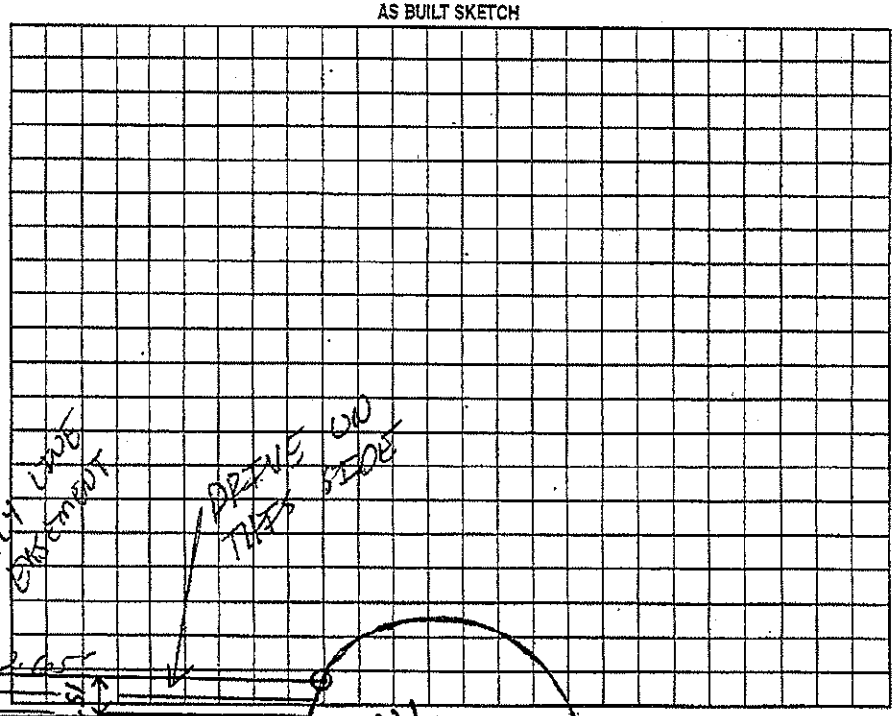

Permit can be suspended or revoked if any false information is supplied toward securing the permit/any unauthorized changes are made to the site/any unauthorized changes are made in the installation of the system. Improvement Permit with plat valid without expiration. Improvement Permit with site plan valid for sixty months. Authorization to Construct is valid for a period equal to that of Improvement Permit, not to exceed sixty months.

Signed: Bryan Kennedy date 4/7/03

Improvement Permit by: date 04-04-03

Authorization to Construct by: date 04-04-03

Installed by: CRAIG THOMASON

Operation Permit by: date 4-14-03

Existing System Inspection by: date

HEALTH DEPT. COPY: WHITE OWNER COPY (FINAL): YELLOW OWNER COPY (INITIAL): PINK