IREDELL COUNTY HEALTH DEPARTMENT

Statesville Office (704) 878-5305 Mooresville Office (704) 660-3625 PERMIT # 208869

IMPROVEMENT PERMIT / AUTHORIZATION TO CONSTRUCT / OPERATION PERMIT / EXISTING SYSTEM

PIN # 4765593123

APPLICANT: Desiree Allen APPLICANT ADDRESS: 125 Rivergreen Dr Statesville NC

SITE ADDRESS: 125 Rivergreen Dr Statesville NC PHONE: 704-402-6652 ALT. PHONE: 450-7955

SITE DIRECTIONS: 64 E T/L Rivehill Rd T/L Rivergreen Dr on left in cul-de-sac

SUBDIVISION: Rivergreen SECTION: N/A LOT # 22 LOT AREA: 1.2488ac DESIGN FLOW: 480 L.T.A.R.: 0.3

Septic Tank Existing (gal) STB Date

Pump Tank (gal) PT Date

Pump Make Model Serial #

Nitrification Fields 1 # Lines 1 Linear Ft: 100

Trench Width 36" Max. Trench Bottom Depth 36" Gravel Depth N/A

☐ New System ☐ Repair ☒ Expansion System Type: I II III IV V VI

System Description: 25% Reduction

Repair System Description: 50% Reduction

Maintenance Agreement Required: ☐ YES ☒ NO

☑ GRAVITY ☐ PRESSURE

☒ Residence No. Bedrooms 4

☐ Business No. Persons 8

☐ Other No. Employees


☐ Slab ☒ Crawl Space

☐ Basement w/plumbing ☐ Basement w/o plumbing


Water Supply: ☐ Private ☒ Public ☐ Community

Comments / Conditions: Install 25% reduction on contour with serial distribution. Check tank, check tee replace if needed. Maintain 20' off easement tail lines

INITIAL SITE SKETCH

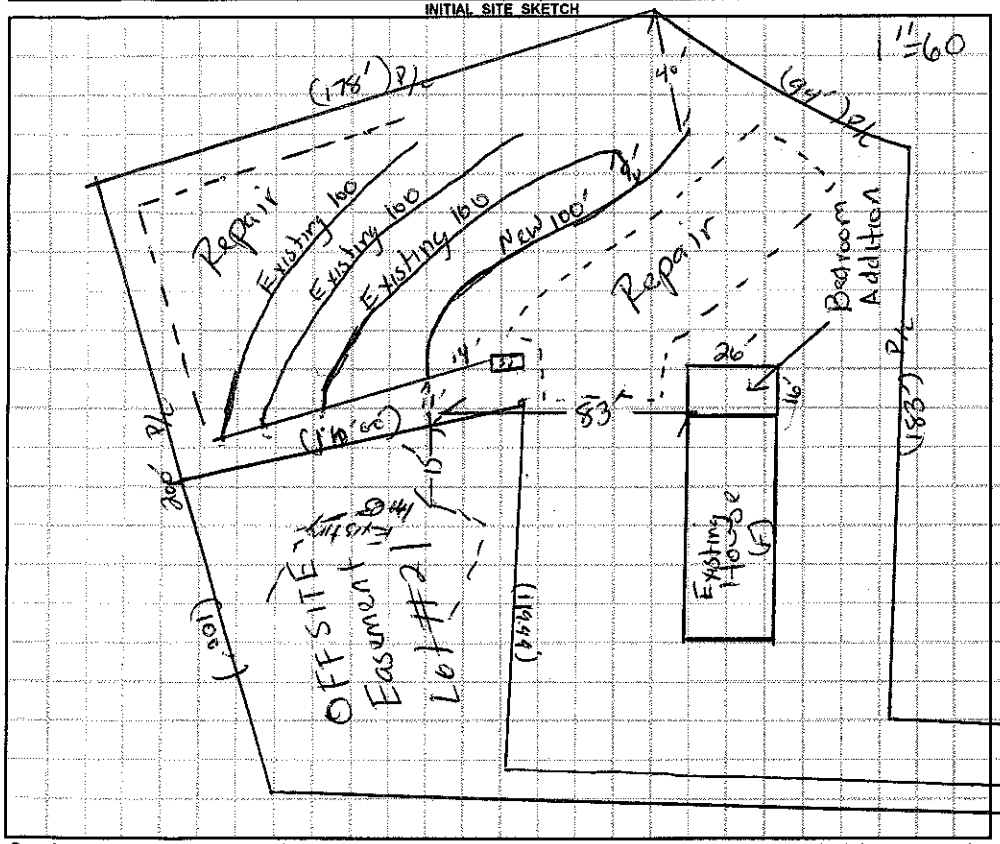

AS BUILT SKETCH

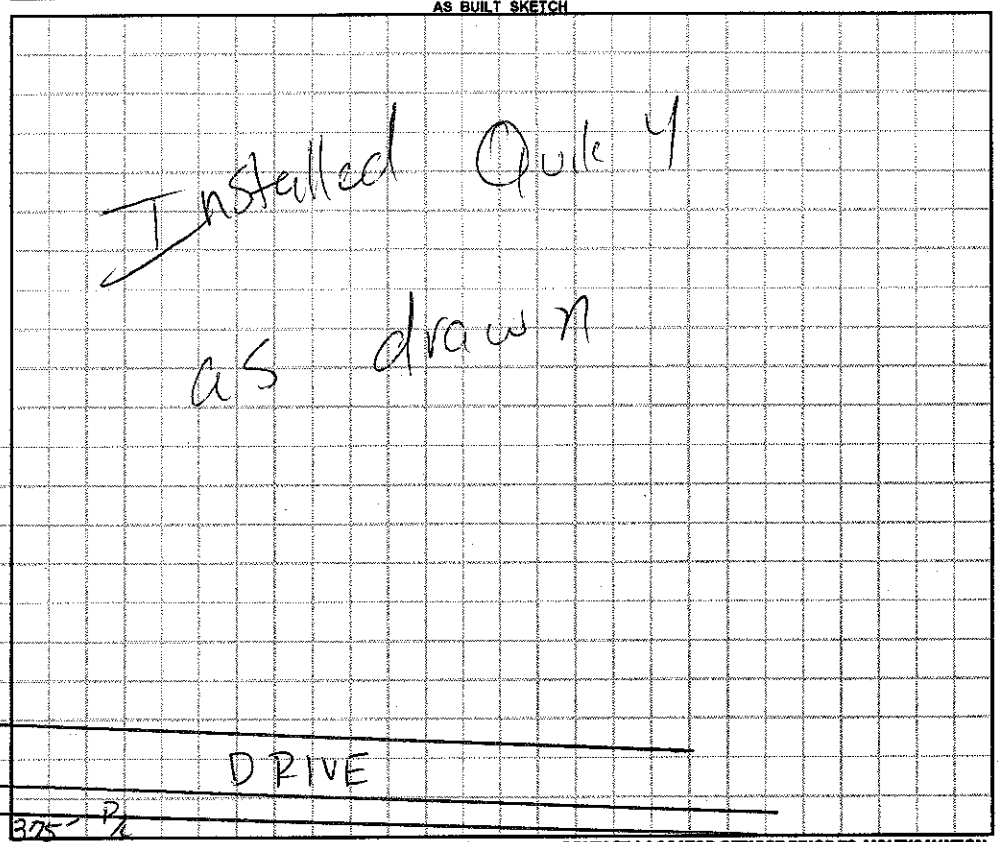

Permit can be suspended or revoked if any false information is supplied toward securing the permit / any unauthorized changes are made to the site / any unauthorized changes are made in the installation of the system. **CONTACT A LOCATOR SERVICE PRIOR TO ANY EXCAVATION**

☐ **IMPROVEMENT PERMIT** *with plat valid without expiration.* ☒ **IMPROVEMENT PERMIT** *with site plan valid for 60 mos.* ☒ **AUTHORIZATION TO CONSTRUCT** *valid for period equal to IMPROVEMENT PERMIT--not to exceed 60 mo.*

Owner / Applicant Signature: Desiree Allen Date: 3/27/15 Installed by: A-1 Backhoe

IMPROVEMENT PERMIT by: David A. Allen Date: 03/27/15 OPERATION PERMIT by: David A. Allen Date: 04/08/15

AUTHORIZATION TO CONSTRUCT by: David A. Allen Date: 03/27/15 Existing System Inspected by: Date:

Health Dept. Copy - WHITE Applicant (Final Approval) - YELLOW Applicant (Conditional Approval) - PINK