IREDELL COUNTY HEALTH DEPARTMENT

STATESVILLE 704-878-5305 CI MOORESVILLE 704-664-5281

IMPROVEMENT PERMIT / AUTHORIZATION TO CONSTRUCT / OPERATION PERMIT / EXISTING SYSTEM INSPECTION

PERMIT# 111649 PIN# 4765-59-3123 DATE 04-04-03

OWNER OR CONTRACTOR FLEETWOOD HOMES OF STATESVILLE PHONE: Business 704-872-0179 Home

ADDRESS 1270 NORTHSIDE DR STATESVILLE, NC 28677

LOCATION 64 EAST, (L) RIVERHILL RD, (L) RIVERGREEN, ON LEFT IN CUL-DE-SAC

SUBDIVISION RIVERGREEN BLOCK / SECTION LOT 22 LOT AREA 1.2438 SITE CLASS. PS DESIGN FLOW 360 L.T.A.R. .13

Septic Tank: 1000 Gallons; STB 1612 Date 8-2467

Pump Tank: Gallons; PT Date

Pump Make: Model Serial No.

Nitrification Field: No Fields 1 Square Feet EQ=1260' Linear Feet 300'

No Lines 3x100' Trench Width 36" Max Trench Bottom Depth 36" Gravel Depth N/A

☒ New System ☐ Repair System Type: I, II, (III), IV, V, VI

System Description: GRAV @ 2540 RED

Repair System Description: LP PANEL

Maintenance Agreement Required: ☐ Yes ☒ No

☐ House/Mod. Home ☒ Mobile Home ☐ Business ☐ Other

No. Bedrooms 3 No. Bathrooms 2 No. Employees


☐ Slab ☒ Crawl Space ☐ Basement w/plumbing ☐ Basement wo/plumbing

Water Supply: ☐ Individual ☒ Public ☐ Community


Comments:/Conditions: (1) INSTALL LINES ON CONTOURS (2) MAINTAIN SETBACKS (3) SEPTIC LINES FLAGGED WT IN WHITE & BLUE; (4) THIS LOT HAS AN OFF SITE EASEMENT ON PROPERTY, (5) KEEP DRIVEWAY

Comments:/Conditions: OFF 10' SUPPLY EASEMENT TUFF TITE FILTER & MANIFOLD, EZ FLOW INSTALLED AS DRAWN, HOUSE/D/W NOT SET UP @ time of check

"NOT TO SCALE" INITIAL SITE SKETCH

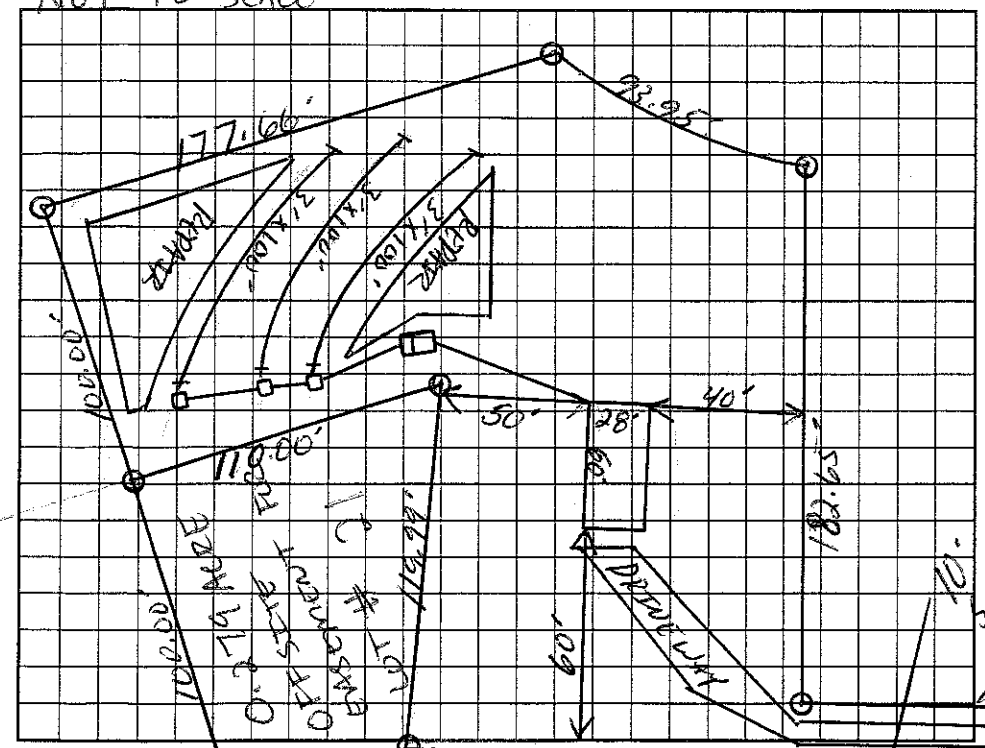

AS BUILT SKETCH

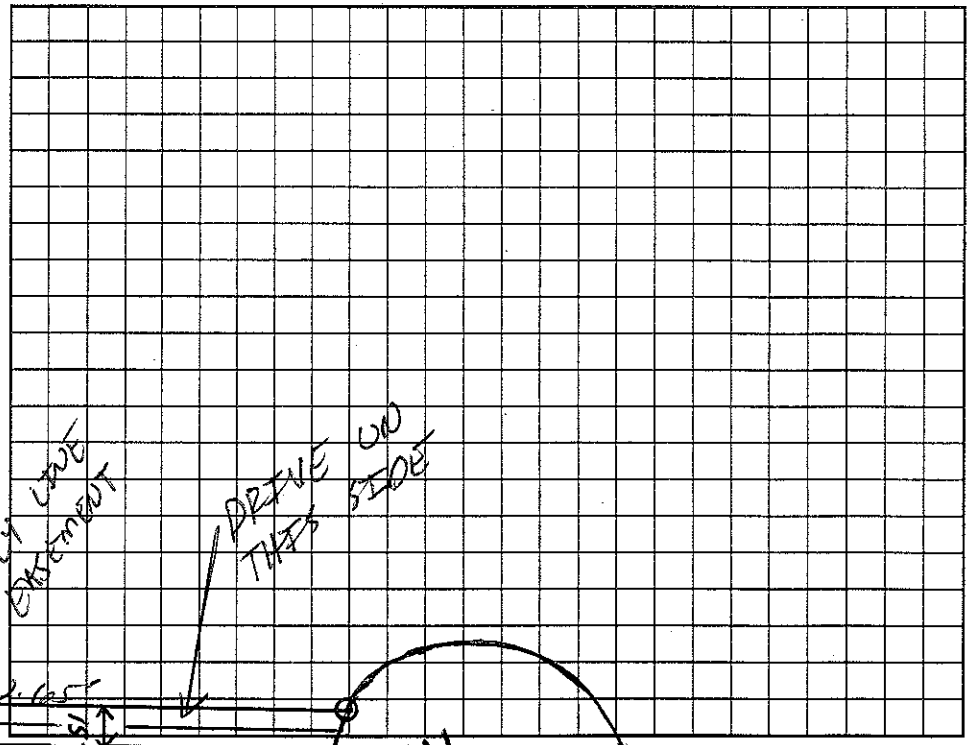

Permit can be suspended or revoked if any false information is supplied toward securing the permit/any unauthorized changes are made to the site/any unauthorized changes are made in the installation of the system. Improvement Permit with plat valid without expiration; Improvement Permit with site plan valid for sixty months. Authorization to Construct is valid for a period equal to that of Improvement Permit not to exceed sixty months.

Signed: Bryan Sawyer date 4/7/03 Installed by: CRAIG THOMPSON

Improvement Permit by: date 04-04-03 Operation Permit by: date 4-14-03

Authorization to Construct by: date 04-04-03 Existing System Inspection by: date

HEALTH DEPT. COPY: WHITE OWNER COPY (FINAL): YELLOW OWNER COPY (INITIAL): PINK