IREDELL COUNTY HEALTH DEPARTMENT

STATESVILLE 704-878-5305 (C1) MOORESVILLE 704-664-5281

IMPROVEMENT PERMIT / AUTHORIZATION TO CONSTRUCT / OPERATION PERMIT / EXISTING SYSTEM INSPECTION

PERMIT# 113509 PIN# 4765-59-5112 DATE 7-12-03

OWNER OR CONTRACTOR FLEETWOOD HOMES PHONE: Business 704-406-7019 Home

ADDRESS 1270 NORTHSIDE DR STATESVILLE NC 28677

LOCATION 64 EAST, L RIVERHILL RD, L RIVERGREEN [redacted] AT END IN CUL-DE-SAC

SUBDIVISION RIVERGREEN BLOCK / SECTION LOT 23 LOT AREA .6546 SITE CLASS. PS DESIGN FLOW 480 L.T.A.R. .3

Septic Tank: 1000 Gallons; STB 1012 Date 6-3-03
Pump Tank: 1000 Gallons; PT 17 Date 5-28-03
Pump Make: MYERS Model SUBE 50 Serial No.
Nitrification Field: No. Fields 1 Square Feet EQ=160 Linear Feet 270'
No Lines 6x45' Trench Width 24" Max Trench Bottom Depth 36" Gravel Depth N/A

☒ New System ☐ Repair System Type: I, II, III, IV, V, VI
System Description: PUMP PANEL PRESS. MANIFOLD
Repair System Description: LP PANEL
Maintenance Agreement Required: ☐ Yes ☒ No

☐ House/Mod. Home ☒ Mobile Home ☐ Business ☐ Other
No. Bedrooms 4 No. Bathrooms 2 No. Employees


☐ Slab ☒ Crawl Space ☐ Basement w/plumbing ☐ Basement wo/plumbing

Water Supply: ☐ Individual ☒ Public ☐ Community


Comments:/Conditions: ① SYSTEM + HOUSE IS FLAGGED OUT (COMPLETELY ② INSTALL LINES ON CONTOURS + MAINTAIN SETBACKS. ③ DO NOT CUT DRIVE. REPAIR AREA WILL NOT BE USED

Comments:/Conditions: IF DRIVE IS CUT IN ④ MAINTAIN SETBACKS FOR THE TANKS, ⑤ PAD NEEDS TO BE FILLED SO COMMENT #4 CAN BE ACHIEVED

INITIAL SITE SKETCH 1" ≈ 50'

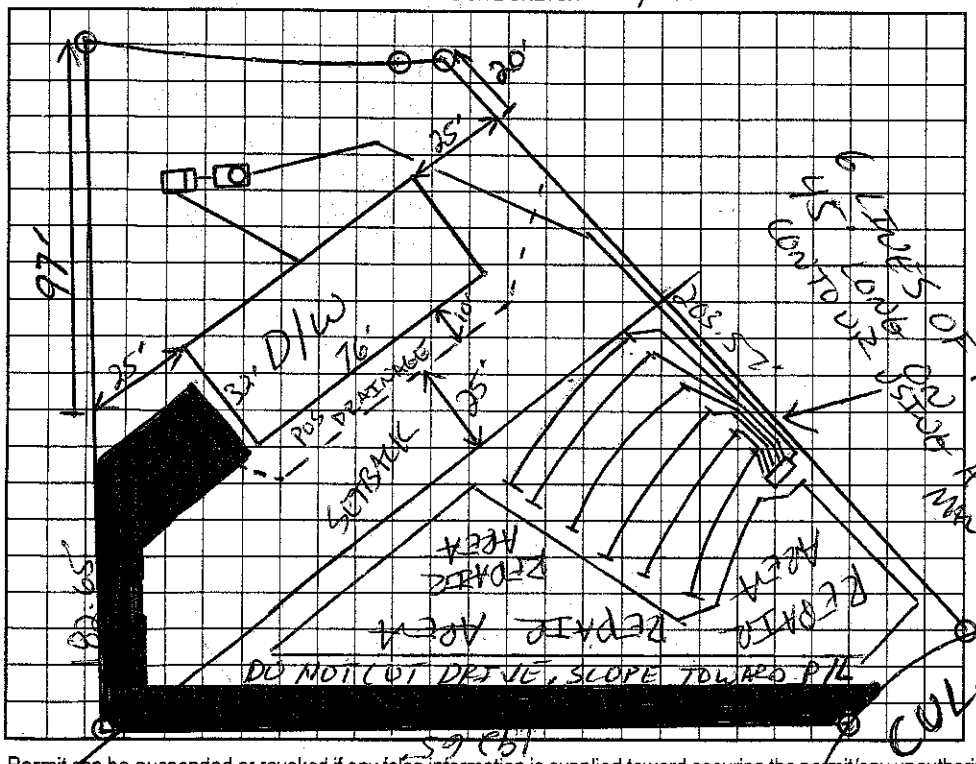

AS BUILT SKETCH

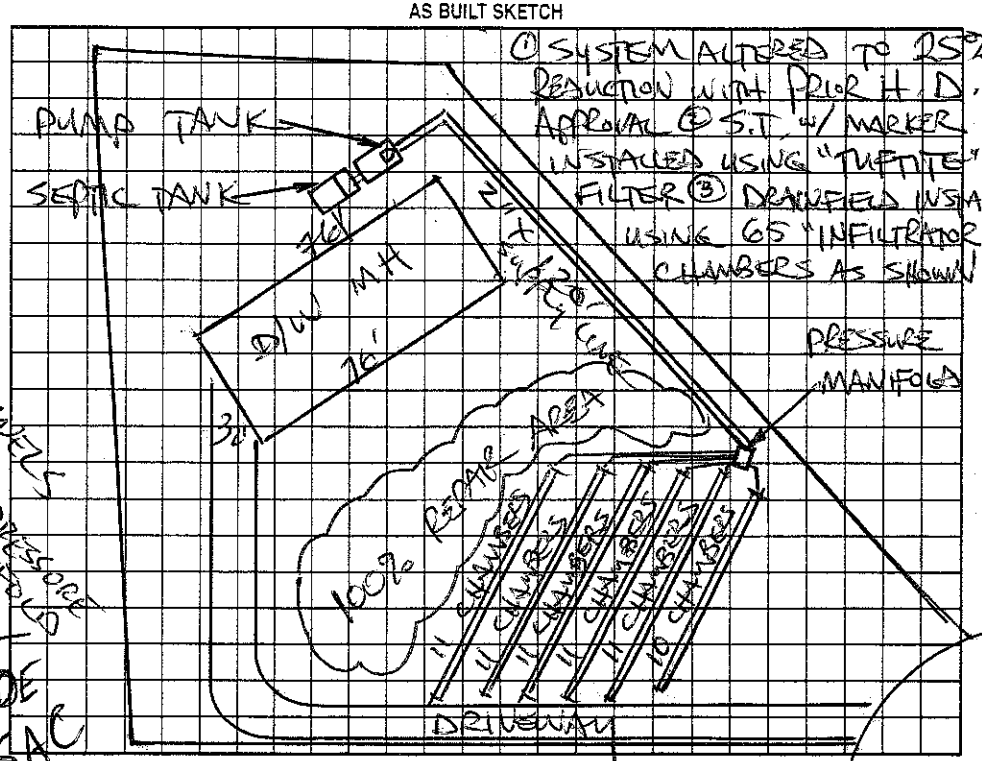

Permit can be suspended or revoked if any false information is supplied toward securing the permit/any unauthorized changes are made to the site/any unauthorized changes are made in the installation of the system. Improvement Permit with plat valid without expiration. Improvement Permit with site plan valid for sixty months. Authorization to Construct is valid for a period equal to that of Improvement Permit – not to exceed sixty months.

Signed: date 10/11/03 Installed by: CRAIG THOMPSON

Improvement Permit by: RS date 7-12-03 Operation Permit by: STEVE HEDRICK date 12-15-03

Authorization to Construct by: RS date 7-12-03 Existing System Inspection by: date

HEALTH DEPT. COPY: WHITE OWNER COPY (FINAL): YELLOW OWNER COPY (INITIAL): PINK