IREDELL COUNTY HEALTH DEPARTMENT

STATESVILLE 704-878-5305 CI MOORESVILLE 704-664-5281

IMPROVEMENT PERMIT / AUTHORIZATION TO CONSTRUCT / OPERATION PERMIT / EXISTING SYSTEM INSPECTION

PERMIT# 110513 PIN# 4765-59-7545 DATE 01-06-03

OWNER OR CONTRACTOR TONG LEE PHONE: Business Home 704-924-7880

ADDRESS 405 RIVERHILL RD STATESVILLE, NC 28625

LOCATION 64 E, (L) RIVERHILL RD, (L) ACROSS FROM BOX #405 OFF RD. BESIDE OLDER HOUSE

SUBDIVISION BLOCK / SECTION LOT LOT AREA 3.22 AC SITE CLASS PS DESIGN FLOW 360 L.T.A.R. .3

Septic Tank: 1000 Gallons; STB 1012 Date 5-27-02
Pump Tank: Gallons; PT Date
Pump Make: Model Serial No.
Nitrification Field: No Fields 1 Square Feet 800' Linear Feet 400'
No Lines 4X100' Trench Width 36" Max Trench Bottom Depth 36" Gravel Depth 12"

☒ New System ☐ Repair System Type: I (II) III, IV, V, VI
System Description: CONV GRAV
Repair System Description: SAME
Maintenance Agreement Required: ☐ Yes ☒ No

☐ House/Mod. Home No. Bedrooms 3
☒ Mobile Home DW No. Bathrooms 2
☐ Business No. Employees
☐ Other
☐ Slab ☒ Crawl Space ☐ Basement w/plumbing ☐ Basement wo/plumbing


Water Supply: ☐ Individual ☒ Public ☐ Community

Comments:/Conditions: (1) CALL PRIOR TO INSTALLATION FOR FLAGOUT IF NECESSARY (2) INSTALL LINES ON CONTOUR & MAINTAIN SETBACKS. 44' INTERSTATE 40'


Comments:/Conditions: DO NOT SIGN OFF ON AC UNTIL HOUSE PLANS ARE AVAILABLE) WELL BEHIND HOUSE IS 125' AWAY FROM SEPTIC FIELD,

NOT TO SCALE

INITIAL SITE SKETCH

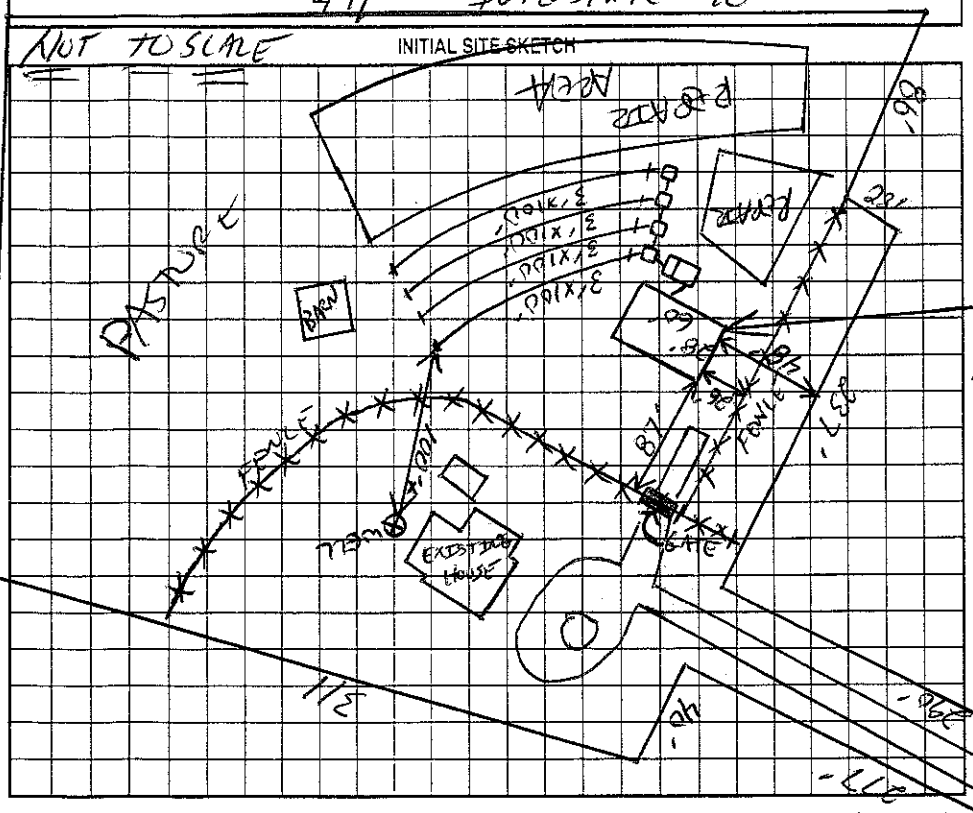

AS BUILT SKETCH

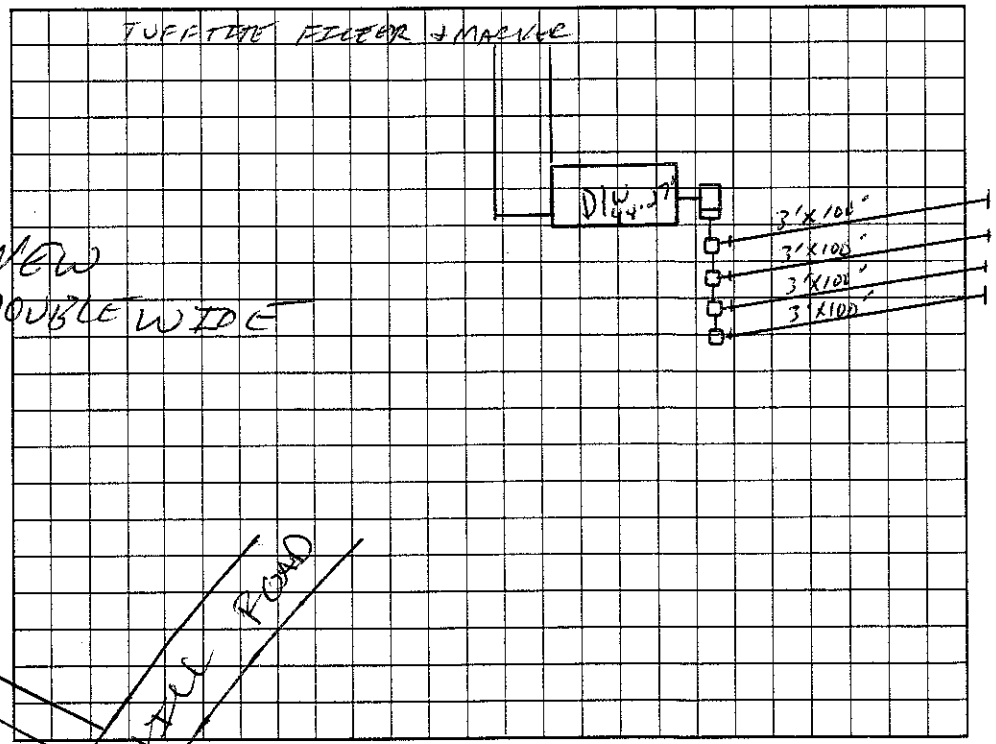

Permit can be suspended or revoked if any false information is supplied toward securing the permit/any unauthorized changes are made to the site/any unauthorized changes are made in the installation of the system. Improvement Permit with plat valid without expiration. Improvement Permit with site plan valid for sixty months. Authorization to Construct is valid for a period equal to that of Improvement Permit – not to exceed sixty months.

Signed: Tong Lee date 01-07-03 Installed by: CRAIG THOMPSON

Improvement Permit by: date 01-06-03 Operation Permit by: RS date 02-05-03

Authorization to Construct by: date 01-30-03 Existing System Inspection by: date

HEALTH DEPT. COPY: WHITE OWNER COPY (FINAL): YELLOW OWNER COPY (INITIAL): PINK