Seth Cochrane – 138 Woodview Dr. - Stat.

IREDELL COUNTY HEALTH DEPARTMENT

STATESVILLE 704-878-5305 (21) MOORESVILLE 704-664-5281

IMPROVEMENT PERMIT / AUTHORIZATION TO CONSTRUCT / OPERATION PERMIT / EXISTING SYSTEM INSPECTION

PERMIT# 115399 PIN# 4765-60-9589 4765 60 8784 DATE 10-2-03

OWNER OR CONTRACTOR SCHULT HOUSING ADVANTAGE PHONE: Business 704-902-1836 Home 704-883-9997

ADDRESS 134 KOA LANE STATESVILLE NC 28677

LOCATION US 64 E, TR BELL FARM RD, TL EVERGREEN WOODS RD, TR BIRCHWOOD RD, TR WOODVIEW DRIVE, 4TH LOT ON RIGHT

SUBDIVISION SUNBROOK BLOCK / SECTION 2 LOT 32-38 LOT AREA 4,082' ACRES SITE CLASS. PS' DESIGN FLOW 480 L.T.A.R. 0.25 GAD/FT²

Septic Tank: 1000 Gallons; STB 1012 Date 5-12-03
Pump Tank: 1000 Gallons; PT 17 Date 6-16-02
Pump Make: Model Serial No.
Nitrification Field: No Fields 1 Square Feet EQ. TO 1920 Linear Feet 480
No Lines FOUR Trench Width 36" Max Trench Bottom Depth 36" Gravel Depth N/A

☑ New System ☐ Repair System Type: I, II, (III), IV, V, VI
System Description: 25% REDUCTION PUMP
Repair System Description: 50% REDUCTION, LOW-
Maintenance Agreement Required: ☐ Yes ☑ No PRESSURE

☑ House/Mod. Home ☐ Mobile Home ☐ Business ☐ Other
No. Bedrooms 4 No. Bathrooms 2 No. Employees


☑ Slab ☑ Crawl Space ☐ Basement w/plumbing ☐ Basement wo/plumbing

Water Supply: ☐ Individual ☑ Public ☐ Community


Comments:/Conditions: ① CONTACT H.D. DEPT. AFTER CLEARING TO FLAG SYSTEM ② INSTALL 25% REDUCTION SYSTEM ON CONTOUR AS FLAGGED. ③ SEE ATTACHED SHEETS FOR PUMP & PRESSURE MANIFOLD REQ. ④ CROSS CREEK IN COMPLIANCE WITH 15A NCAC 18A .1950 (h)

Comments:/Conditions: ① SEPTIC TANK WITH MARKER INSTALLED USING "TUFTITE" FILTER ② TANKS & DRAINFIELD INSPECTED 11-3-03, RSH

INITIAL SITE SKETCH

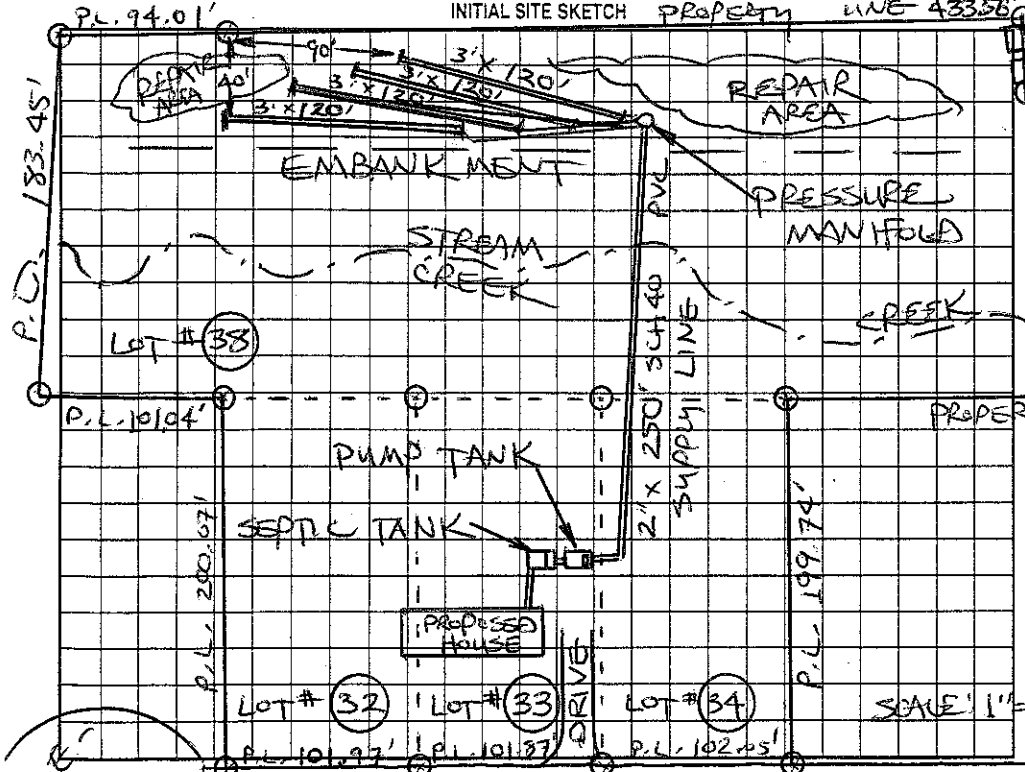

AS BUILT SKETCH

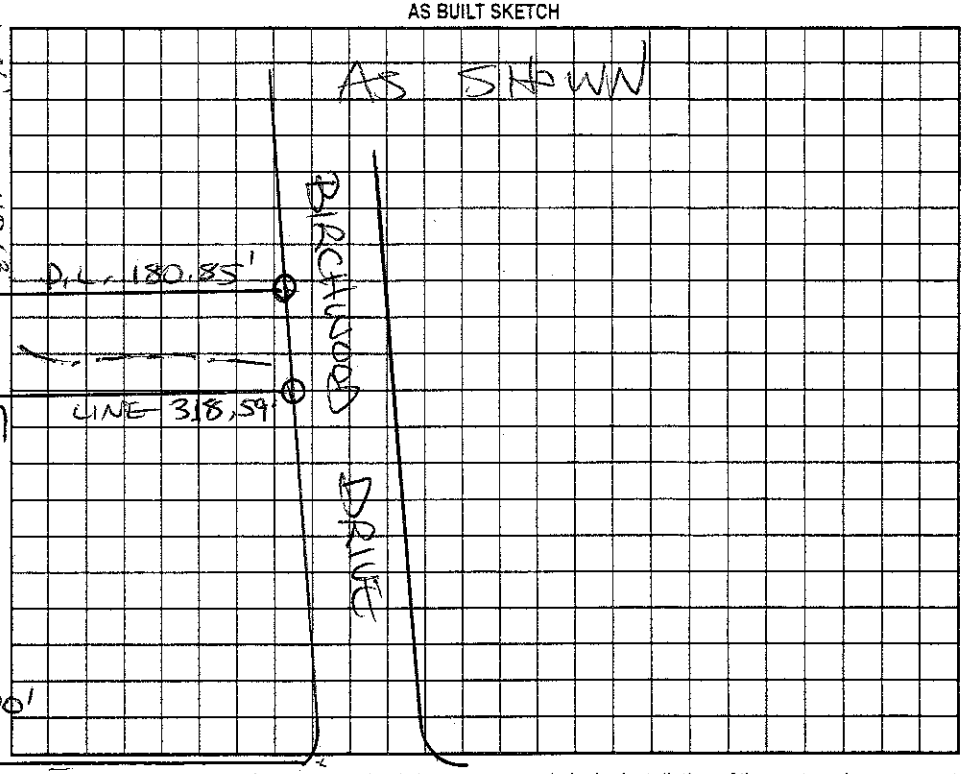

Permit can be suspended or revoked if any false information is supplied toward securing the permit/any unauthorized changes are made to the site/any unauthorized changes are made in the installation of the system. Improvement Permit with plat valid without expiration. Improvement Permit with site plan valid for sixty months. Authorization to Construct is valid for a period equal to that of Improvement Permit – not to exceed sixty months.

Signed: _____ date _____ Installed by: A-1 BACKHOE

Improvement Permit by: STEVE HEDRICK date 10-2-03 Operation Permit by: STEVE HEDRICK date 11-13-03

Authorization to Construct by: STEVE HEDRICK date 10-2-03 Existing System Inspection by: _____ date _____

HEALTH DEPT. COPY: WHITE OWNER COPY (FINAL): YELLOW OWNER COPY (INITIAL): PINK