IREDELL COUNTY HEALTH DEPARTMENT

Statesville Office (704) 878-5305 Mooresville Office (704) 660-3625 PERMIT # 180643

IMPROVEMENT PERMIT / AUTHORIZATION TO CONSTRUCT / OPERATION PERMIT / EXISTING SYSTEM

PIN # 4765614721

APPLICANT: (Owner) Nevi Burrifica (Owner) APPLICANT ADDRESS: Same as site address

SITE ADDRESS: 213 Maple Leaf Rd, Statesville PHONE: ALT. PHONE:

SITE DIRECTIONS: Hwy 64 East TR Bell Farm Rd TL Maple Leaf on left near end - #213


SUBDIVISION: Cedar Hills SECTION: LOT # 71 LOT AREA: .4ac DESIGN FLOW: 360gpd L.T.A.R.: .3

Septic Tank	1000 (gal)	STB	Date	☐ New System	☒ Repair	☐ Expansion	System Type: I II (III) IV V VI	☒ Residence	No. Bedrooms 3
Pump Tank	(gal)	PT	Date	System Description:				☐ Business	No. Persons 5
Pump Make		Model	Serial #	Repair System Description:	gravity 25% Reduction			☐ Other	No. Employees
# Nitrification Fields	# Lines 3		Linear Ft: 200	Maintenance Agreement Required:	☐ YES	☒ NO		☐ Slab	☐ Crawl Space
Trench Width 36"	Max. Trench Bottom Depth 36"		Gravel Depth NA		☒ GRAVITY	☐ PRESSURE		☐ Basement w/plumbing	☐ Basement w/o plumbing

Water Supply: ☐ Private ☒ Public ☐ Community

Comments / Conditions: Pump tank & check condition; If needed, replace w/ new 1000 gallon tank. Owner can consider "Terra Lift" procedure: Drainfield had no sewage surfacing at time of visit.

INITIAL SITE SKETCH

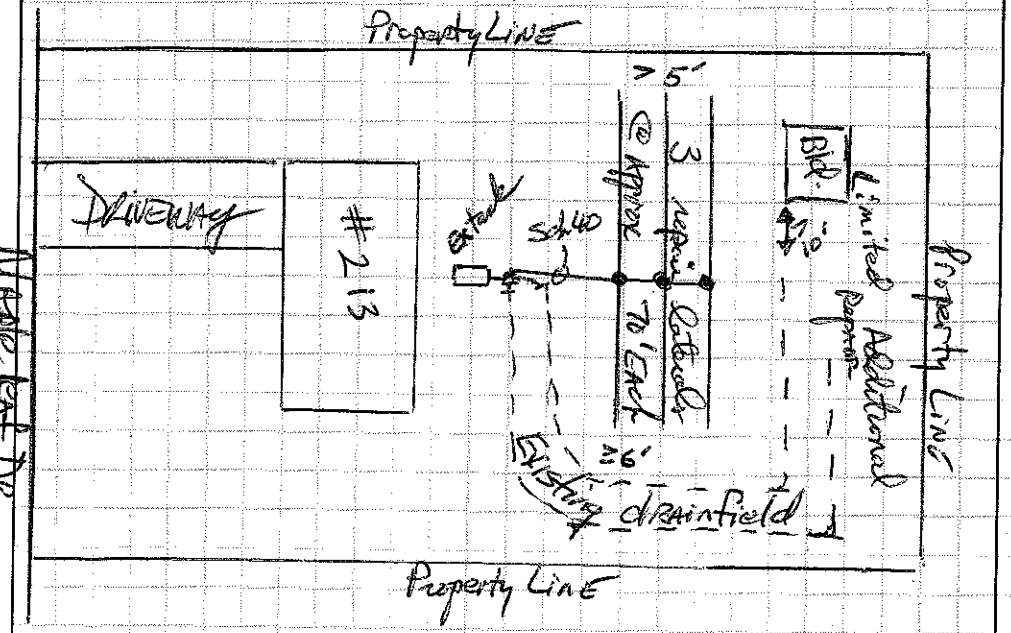

AS BUILT SKETCH

- Quick 4 Chambers installed
- Installed as drawn

Permit can be suspended or revoked if any false information is supplied toward securing the permit / any unauthorized changes are made to the site / any unauthorized changes are made in the installation of the system. **CONTACT A LOCATOR SERVICE PRIOR TO ANY EXCAVATION**

☐ **IMPROVEMENT PERMIT** *with plat valid without expiration.* ☐ **IMPROVEMENT PERMIT** *with site plan valid for 60 mos.* ☐ **AUTHORIZATION TO CONSTRUCT** *valid for period equal to IMPROVEMENT PERMIT--not to exceed 60 mo.*

Owner / Applicant Signature: [signature] Date: 030CT13 Installed by: Steve Jordan

IMPROVEMENT PERMIT by: Date: OPERATION PERMIT by: Justin Henderson Date: 10-22-13

AUTHORIZATION TO CONSTRUCT by: [signature] Date: Sept 17, 2013 Existing System Inspected by: Date:

Health Dept. Copy - WHITE Applicant (Final Approval) - YELLOW Applicant (Conditional Approval) - PINK