IREDELL COUNTY HEALTH DEPARTMENT

STATESVILLE 704-878-5305 MOORESVILLE 704-664-5281

47620

IMPROVEMENT PERMIT / CERTIFICATE OF COMPLETION / OPERATION PERMIT / EXISTING SYSTEM INSPECTION

PROPERTY DESCRIPTION NO. 16513 DATE 6-16-93 TAX MAP NO. 5527 A-8

OWNER OR CONTRACTOR Hayden Hamby PHONE: Business _____ Home 871 8117

ADDRESS Rt 12 Box 240 Statesville

LOCATION 64E TR Bell Fm Rd Th Birchwood Th Hamby Lane 1st Hse on left

SUBDIVISION Sunbrook BLOCK / SECTION I LOT 8 LOT AREA 110' x 200' SITE CLASS. PS L.T.A.R. .3

Water Supply: ☐ Individual ☐ Community ☑ Public

Septic Tank: 1000 Gallons; STB 783 Date 4-30-93

Pump Tank: _____ Gallons; PT _____ Date _____

Nitrification Field: No Fields 1 Square Feet 510 Linear Feet 270

No Lines _____ Trench Width _____ Trench Depth _____ Gravel Depth _____

☑ New System ☐ Repair System Type: I. II. IV. V. VI

System Description: Conv Gravity

Repair System Description: Pump to conv. lines

Maintenance Agreement Required: ☐ Yes ☑ No

☑ House/Mod. Home No. Bedrooms 2

☐ Mobile Home No. Bathrooms 2

☐ Business No. Employees _____

☐ Other _____

Garbage Disposal: ☐ Yes ☑ No

Auto. Dishwasher: ☐ Yes ☐ No


Auto. Washing Machine: ☐ Yes ☐ No

Other _____

☑ Slab ☐ Crawl Space ☐ Basement w/plumbing ☐ Basement wo/plumbing

Comments Run Surface water around septic Tank System

INITIAL SITE SKETCH

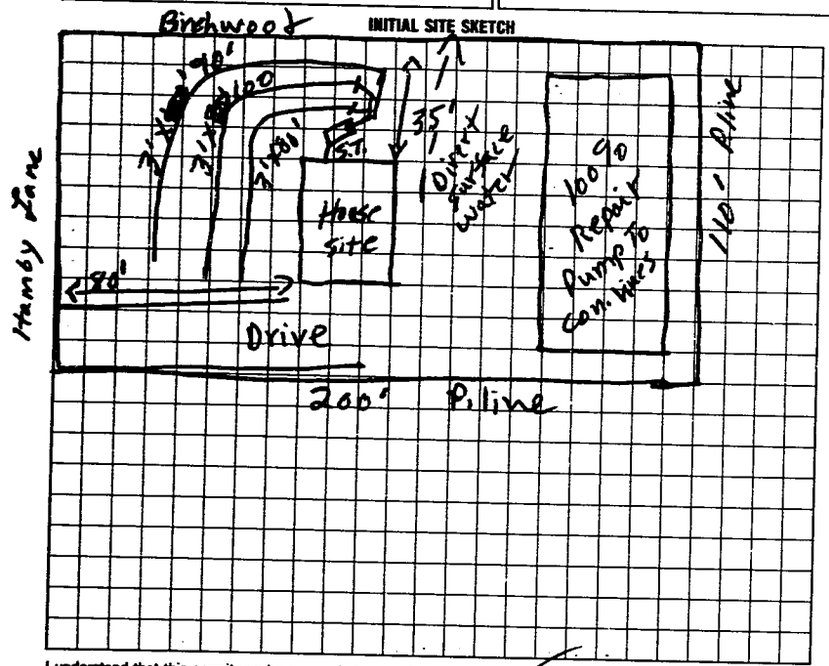

AS BUILT SKETCH

Same as Initial Sketch

I understand that this permit can be suspended or revoked if any false information is supplied toward securing the permit/any unauthorized changes are made to the site/any unauthorized changes are made in the installation of the system. Improvement Permit is valid for 60 months from date of issuance.

Signed: Hayden Hamby

Improvement Permit by: P.C. Moore date 6-16-93

Existing System Inspection by: _____ date _____

Installed by: Donald Lackey

Certificate of Completion by: P.C. Moore date 7-29-93

Operation Permit by: _____ date _____

HEALTH DEPT. COPY: WHITE INSPECTION COPY (FINAL): GREEN OWNER COPY (FINAL): YELLOW INSPECTION COPY (INITIAL): PINK OWNER COPY (INITIAL): GOLD