IREDELL COUNTY HEALTH DEPARTMENT

STATESVILLE 704-878-5305 MOORESVILLE 704-664-5281

IMPROVEMENT PERMIT / CERTIFICATE OF COMPLETION / OPERATION PERMIT / EXISTING SYSTEM INSPECTION

PROPERTY DESCRIPTION NO. _____ DATE 5-13-96 TAX MAP NO. _____ Watershed: ☐ Yes ☐ No

OWNER OR CONTRACTOR James Hickman PHONE: Business _____ Home _____

ADDRESS 179 Mapleleaf Drive

LOCATION 64E TR 6 Bell Rd Tl Mapleaf 1/4mi left

SUBDIVISION Cedar Hills BLOCK / SECTION _____ LOT 65 LOT AREA 1/2 acre SITE CLASS. _____ DESIGN FLOW _____ L.T.A.R. _____

Septic Tank: _____ Gallons; STB _____ Date _____

Pump Tank: _____ Gallons; PT _____ Date _____

Pump Make: _____ Model _____ Serial No. _____

Nitrification Field: No Fields ____ Square Feet _____ Linear Feet _____

No Lines _____ Trench Width _____ Max Trench Bottom Depth _____ Gravel Depth _____

☐ New System ☐ Repair System Type: I, II, III, IV, V, VI

System Description: _____

Repair System Description: French Drain

Maintenance Agreement Required: ☐ Yes ☐ No

☐ House/Mod. Home No. Bedrooms ____

☐ Mobile Home No. Bathrooms ____

☐ Business No. Employees ____

☐ Other _____


☐ Slab ☐ Crawl Space ☐ Basement w/plumbing ☐ Basement wo/plumbing

Water Supply:
☐ Individual
☐ Community
☐ Public

Comments: Ground water getting into system will be cut off + discharged to Storm Drain

Comments:

INITIAL SITE SKETCH

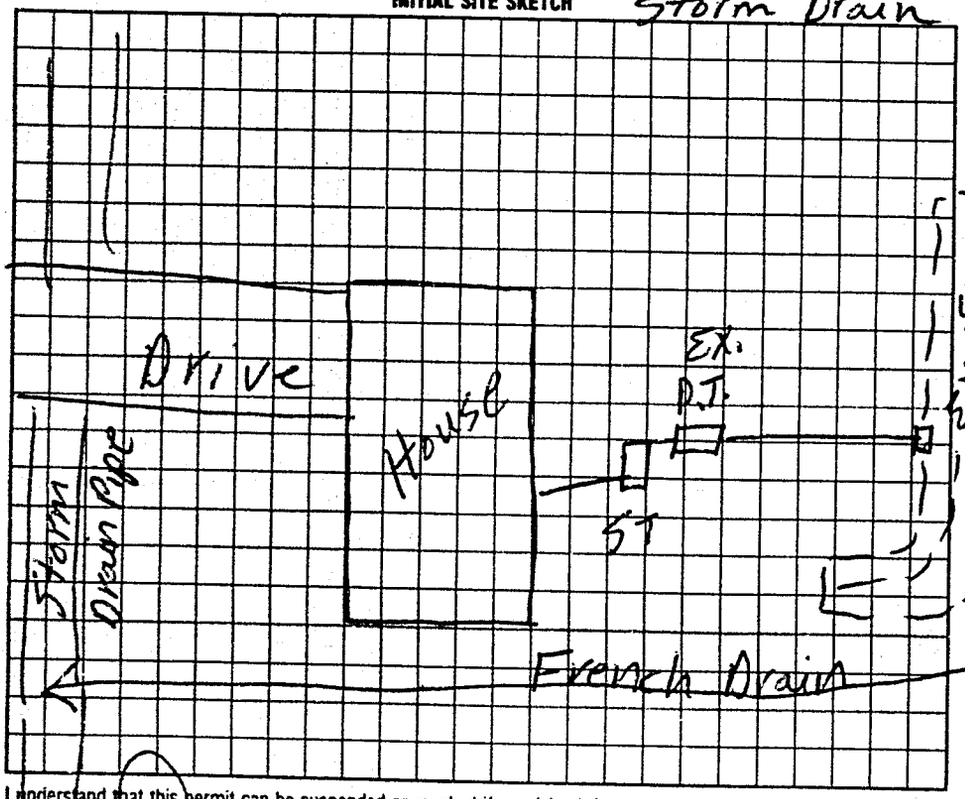

AS BUILT SKETCH

Same as initial sketch

I understand that this permit can be suspended or revoked if any false information is supplied toward securing the permit/any unauthorized changes are made to the site/any unauthorized changes are made in the installation of the system.

Signed: X James Hickman

Improvement Permit by: L.C. moore date 5-13-96

Existing System Inspection by: L.C. moore date 5-13-96

Installed by: Barry Sigmon

Certificate of Completion by: _____ date _____

Operation Permit by: L.C. moore date 10-30-96

authorization to const

HEALTH DEPT COPY: WHITE INSPECTION COPY (FINAL): GREEN OWNER COPY (FINAL): YELLOW INSPECTION COPY (INITIAL): PINK OWNER COPY (INITIAL): GOLD

Authorization to const Expires 60 mos from issue