IREDELL COUNTY HEALTH DEPARTMENT

STATESVILLE 704-878-5305 MOORESVILLE 704-664-5281

IMPROVEMENT PERMIT / AUTHORIZATION TO CONSTRUCT / OPERATION PERMIT / EXISTING SYSTEM INSPECTION

PERMIT# _____ PIN# 4765-62-3459 DATE 7-29-03

OWNER OR CONTRACTOR LARRY HICKMAN PHONE: Business _____ Home 704-873-1568

ADDRESS 181 MAPLE LEAF DR STATESVILLE, NC 28677

LOCATION 64 EAST (12) BELL, (1) MAPLE LEAF, ON LEFT AT BOX # 181

SUBDIVISION CEDAR HILLS BLOCK / SECTION _____ LOT 64 LOT AREA _____ SITE CLASS. _____ DESIGN FLOW 360 L.T.A.R. EXISTING

Septic Tank: EXISTING Gallons; STB _____ Date _____

Pump Tank: _____ Gallons; PT _____ Date _____

Pump Make: _____ Model _____ Serial No. _____

Nitrification Field: No Fields ____ Square Feet _____ Linear Feet _____

No Lines _____ Trench Width _____ Max Trench Bottom Depth _____ Gravel Depth _____

☐ New System ☒ Repair System Type: I, II, III, IV, V, VI

System Description: _____

Repair System Description: NEW BOX / SPEED LEVELERS

Maintenance Agreement Required: ☐ Yes ☒ No

☒ House/Mod. Home No. Bedrooms 3

☐ Mobile Home No. Bathrooms 2

☐ Business No. Employees ____

☐ Other _____


☐ Slab ☒ Crawl Space ☐ Basement w/plumbing ☐ Basement wo/plumbing

Water Supply: ☐ Individual ☒ Public ☐ Community

Comments/Conditions: (1) DIG UP BOX & REPLACE IF NECESSARY. MAY REQUIRE ONLY SPEED LEVELERS TO CORRECT THE FAILING SYSTEM (2) IT APPEARS THAT THE LAST LINE IS GETTING ALL THE EFFLUENT

Comments/Conditions: (3) THIS PERMIT SERVES AS NOTICE OF VIOLATION & MUST BE REPAIRED WITHIN 30 DAYS OF SIGNING.


INITIAL SITE SKETCH

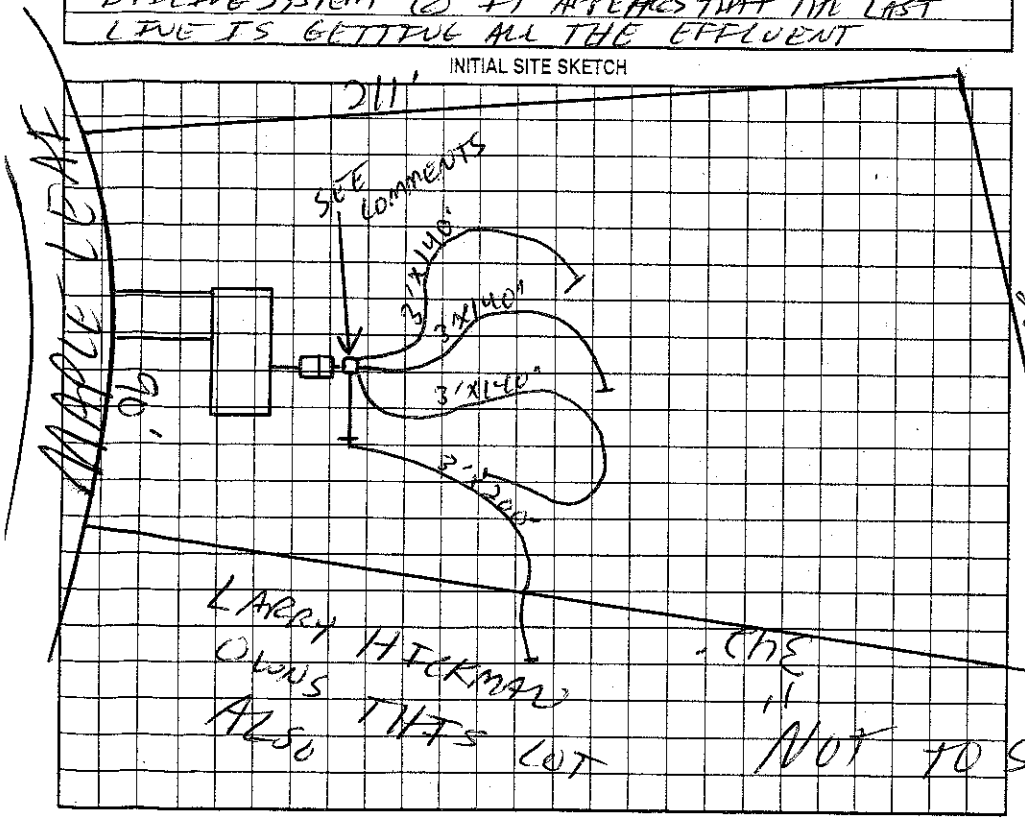

AS BUILT SKETCH

PUMPED TANK & REPLACED TEE & DIST BOX WITH SPEED LEVELERS.

1ST THREE LINES ARE FED OUT OF 1 LINE FROM DIST. BOX. THAT'S THE WAY THE OLD BOX WAS SET UP. REPAIR LINE FED LAST WITH SPEED LEVERS IN NEW BOX. DRAWN LIKE BELOW.

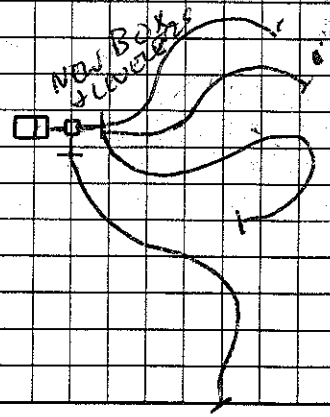

Permit can be suspended or revoked if any false information is supplied toward securing the permit/any unauthorized changes are made to the site/any unauthorized changes are made in the installation of the system. Improvement Permit with plat valid without expiration. Improvement Permit with site plan valid for sixty months. Authorization to Construct is valid for a period equal to that of Improvement Permit – not to exceed sixty months.

Signed: X LARRY HICKMAN date _____

Improvement Permit by: _____ date 7-29-03

Authorization to Construct by: _____ date 7-29-03

Installed by: JAMES HUDDLER

Operation Permit by: _____ date 8-29-03

Existing System Inspection by: _____ date _____

HEALTH DEPT. COPY: WHITE OWNER COPY (FINAL): YELLOW OWNER COPY (INITIAL): PINK