IREDELL COUNTY HEALTH DEPARTMENT

Statesville Phone TR 3-7271 Mooresville Phone NO 3-1271

PERMIT TO INSTALL SEPTIC TANK

Permit NO._____ Permit Date May 23 1962

Owner Hare Address Mocksville Rt.

Installed By Hoke Address R7


Location of Property on left past Beavers Store old 2 story house

Tank	Capacity	Length of Lines	Fixtures
Block ( )	800 ( )	150' ( )	No. of Baths (1)
Precast (1)	900 ( )	175' ( )	Dishwasher ( )
	1000 (1)	200' ( )	Garbage Grdr. ( )
	1100 ( )	225' (1)	Auto-Washer ( )
Cash	1200 ( )	250' ( )	Other_____
	Other_____	Other_____	

NOTIFY HEALTH DEPARTMENT AT LEAST EIGHT HOURS BEFORE TANK IS TO BE INSPECTED.

Final Inspection May 23 1962 Approved (1) Disapproved ( )

Remarks_____

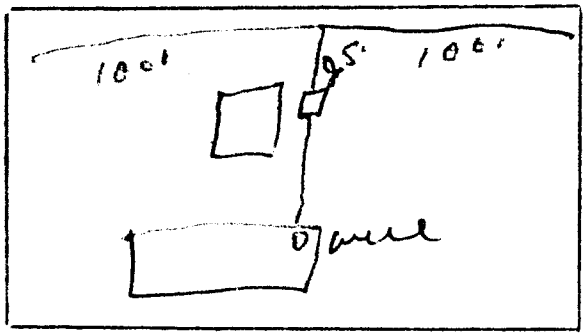

Sketch of Installation

K.T.

Sanitarian