46725

IREDELL COUNTY HEALTH DEPARTMENT

STATESVILLE 704-878-5305 MOORESVILLE 704-664-5281

IMPROVEMENT PERMIT / CERTIFICATE OF COMPLETION / OPERATION PERMIT / EXISTING SYSTEM INSPECTION

PROPERTY DESCRIPTION NO. 15743 DATE 6-30-93 TAX MAP NO. 11E-2- A-48-49

OWNER OR CONTRACTOR Tony Marlow PHONE: Business Home

ADDRESS

LOCATION 64E TL Riverhill Rd TR Oak Haven on Rt at end of st.

SUBDIVISION Country Woods BLOCK / SECTION LOT 48&49 LOT AREA 1 acre SITE CLASS. P.S. L.T.A.R. .28

Water Supply: ☐ Individual ☑ Community ☑ Public

Septic Tank: 1000 Gallons; STB 782 Date 4-23-93

Pump Tank: Gallons; PT Date

Nitrification Field: No Fields 1 Square Feet Linear Feet

No Lines Trench Width Trench Depth Gravel Depth

☑ New System ☐ Repair System Type: I. II. III. IV. V. VI

System Description: 260' Perus Block Panel

Repair System Description: ultra shallow LPP

Maintenance Agreement Required: ☐ Yes ☑ No

☑ House/Mod. Home No. Bedrooms 3

☐ Mobile Home No. Bathrooms 2

☐ Business No. Employees

☐ Other

☐ Slab ☑ Crawl Space ☐ Basement w/plumbing ☐ Basement wo/plumbing

Garbage Disposal: ☐ Yes ☑ No

Auto. Dishwasher: ☐ Yes ☑ No


Auto. Washing Machine: ☐ Yes ☐ No

Other


Comments House was set too low To Get System Repair area in front - will Need to Go to low Pressure Pipe Repair in rear of house as shown on Sketch

Repair if needed will Require maintenance agreement & Registered Engineer to lay-out Repair

INITIAL SITE SKETCH

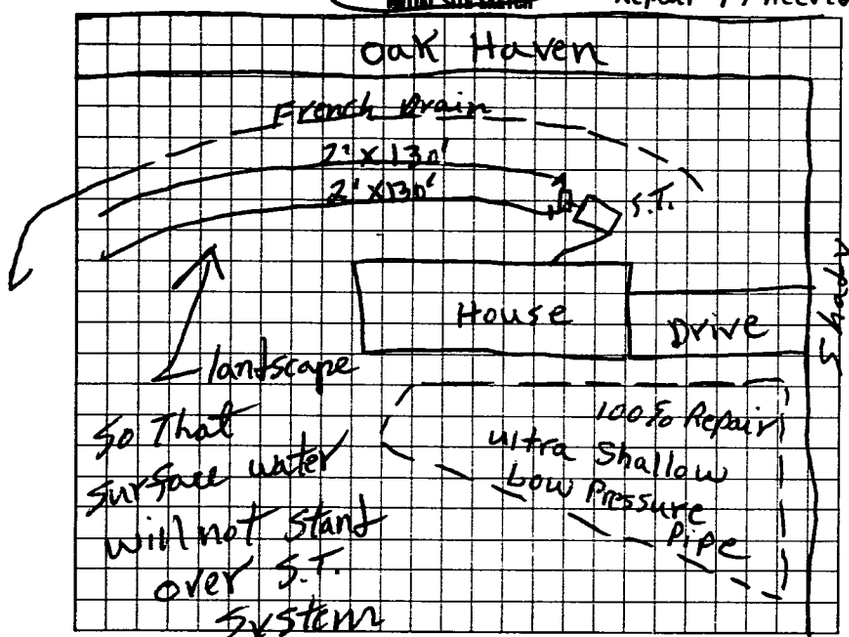

AS BUILT SKETCH

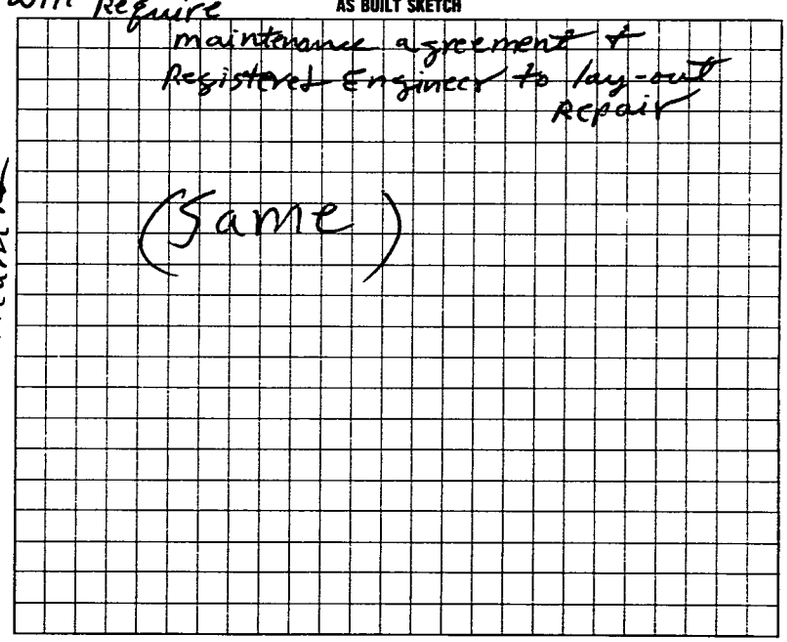

I understand that this permit can be suspended or revoked if any false information is supplied toward securing the permit/any unauthorized changes are made to the site/any unauthorized changes are made in the installation of the system. Improvement Permit is valid for 60 months from date of issuance.

Signed:

Improvement Permit by: J.C. moore date 7-1-93

Existing System Inspection by: date

Installed by: Kenny Pearson

Certificate of Completion by: J.C. moore date 6-30-93

Operation Permit by: date

HEALTH DEPT. COPY: WHITE INSPECTION COPY (FINAL): GREEN OWNER COPY (FINAL): YELLOW INSPECTION COPY (INITIAL): PINK OWNER COPY (INITIAL): GOLD