City
6456

IREDELL COUNTY HEALTH DEPARTMENT

(SEPTIC TANK) IMPROVEMENTS PERMIT AND CERTIFICATE OF COMPLETION

(Ground Absorption Sewage Disposal System -- G. S. Chapter 130-Article 13C)

OWNER OR CONTRACTOR Norman Richardson DATE 12-19-85 PERMIT NO. _____

PHONE: Business _____ Home _____

LOCATION 64 E Thom Rivershill Rd TR on oak Haven Rd house on left

SUBDIVISION NAME Country Woods LOT NO. 85 S. R. No. _____ SECTION OR BLOCK NO. _____

House (✓) Mobile Home ( ) Business ( ) Other _____


No. Bedrooms 3 No. Bathrooms 2

Garbage Disposal Unit Yes ( ) No (✓)
Auto. Dishwasher Yes (✓) No ( )
Auto. Wash. Machine Yes (✓) No ( )
Site Suitable Yes (✓) No ( )

Lot Area 20,000 sq ft +

Character & Porosity of Soil clay loam
Percolation Rate 5
Topography rolling
Depth to Water Table 10' +
Rock or other impervious formations none

_____ Basement with Plumbing _____ Basement without Plumbing ✓ No Basement

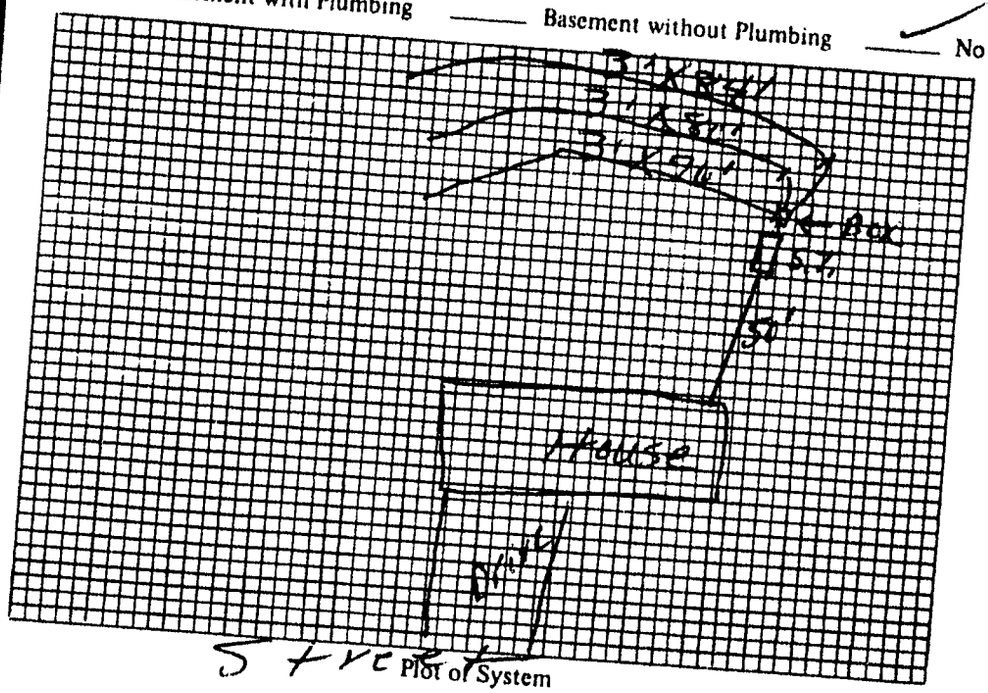

Sketch of System

Size of Tank 1000 Gals.
Nitrification Field:
No. of Lines 3
Sq. Ft. 720 Linear Ft. 240
Depth of Stone in Lines 12"
Water Supply: Individual ( )
Public (✓)

Installed by Eddie Yountz Sons

I understand and agree to install septic tank system as specified on this Improvements Permit.

Signed: _____

IMPROVEMENTS PERMIT BY L. C. Moore

COMMENTS: _____

CERTIFICATE OF COMPLETION BY _____

EXISTING SYSTEM CHECKED BY: L. C. Moore DATE 12-15-85

CONSTRUCTION MUST COMPLY WITH ALL OTHER APPLICABLE STATE AND LOCAL REGULATIONS. DATE _____

Permit is VOID if any unauthorized changes are made in installation of system and/or if any false information is supplied in making Improvements Permit.

Health Dept. Copy: White Inspection Dept. Copy: Yellow Sanitarian's Copy: Pink Owner's Copy: Gold