ICHD - ENVIRONMENTAL HEALTH DIVISION

Statesville Office (704) 878-5305 x3456 Mooresville Office (704) 660-3625

CW

PERMIT : OSWP - 2024 - 54656

PIN # 4765 -- 66 -- 4226

SEPTIC: IMPROVEMENT PERMIT / AUTHORIZATION TO CONSTRUCT / OPERATION PERMIT / EXISTING SYSTEM

APPLICANT/OWNER: JEANIE LENTZ APPLICANT ADDRESS: 463 LENTZ ROAD, STATESVILLE, NC, 28625

SITE ADDRESS: 162 SHADY STREAM DRIVE, STATESVILLE, N.C, 28625 PHONE: 704-906-9549 ALT. PHONE —

SITE DIRECTIONS: (E) ON 64, (L) ON RIVERHILL, (R) ON OAK HAVEN, (L) ON SHADY STREAM, LOT ON (R) SAP CONTROLLED: ☐ YES ☐ NO EXT


SUBDIVISION: COUNTRY WOODS ESTATES SECTION: — LOT # 76-77 LOT AREA: 1.22AC DESIGN FLOW: 360 GPD L.T.A.R.(Initial): EXT L.T.A.R (Repair): EXT

Septic Tank	1000	(gal)	STB 760	Date	☐ New System	☑ Repair	☐ Expansion	System Type: I (II) III IV V VI	☑ Residence	No. Bedrooms	3	Water Supply
Pump Tank	—	(gal)	PT —	Date —	System Description:	EXISTING - CONVENTIONAL			☐ Business	No. Persons	6	☐ Private
Pump Make	—	Model	—	Serial # —	Repair System Description:	TANK REPLACEMENT			☐ Other	No. Employees	—	☑ Public
# Nitrification Fields	EXT	# Lines	EXT	Linear Ft EXT	Maintenance Agreement Required:	☐ YES	☑ NO		☐ Slab	☐ Crawl Space		☐ Community
Trench Width	EXT	*Max. Trench Depth(Initial)	EXT	*Max. Trench Depth(Repair) EXT	Gravel Depth EXT	☑ GRAVITY	☐ PRESSURE		☑ Basement w/plumbing			☐ Basement w/o plumbing

* Measured on the downhill side of the trench Effluent Standard: ☑ DSE ☐ HSE ☐ TS-I ☐ TS-II ☐ RCW ☐ NSF/ANSI 40 Usable Depth to LC (Initial): EXT Usable Depth to LC (Repair): EXT *Limiting Condition*

Comments / Conditions: PUMP, CRUSH, AND FILL EXIST SEPTIC TANK, DO NOT EXCEED 3FT of COVER OVER STANDARD SEPTIC TANK, INSPECT AND REPLACE DISTRIBUTION DEVICES AS NEEDED, SEE PREVIOUS SEPTIC PERMIT FROM 1991


INITIAL SITE SKETCH

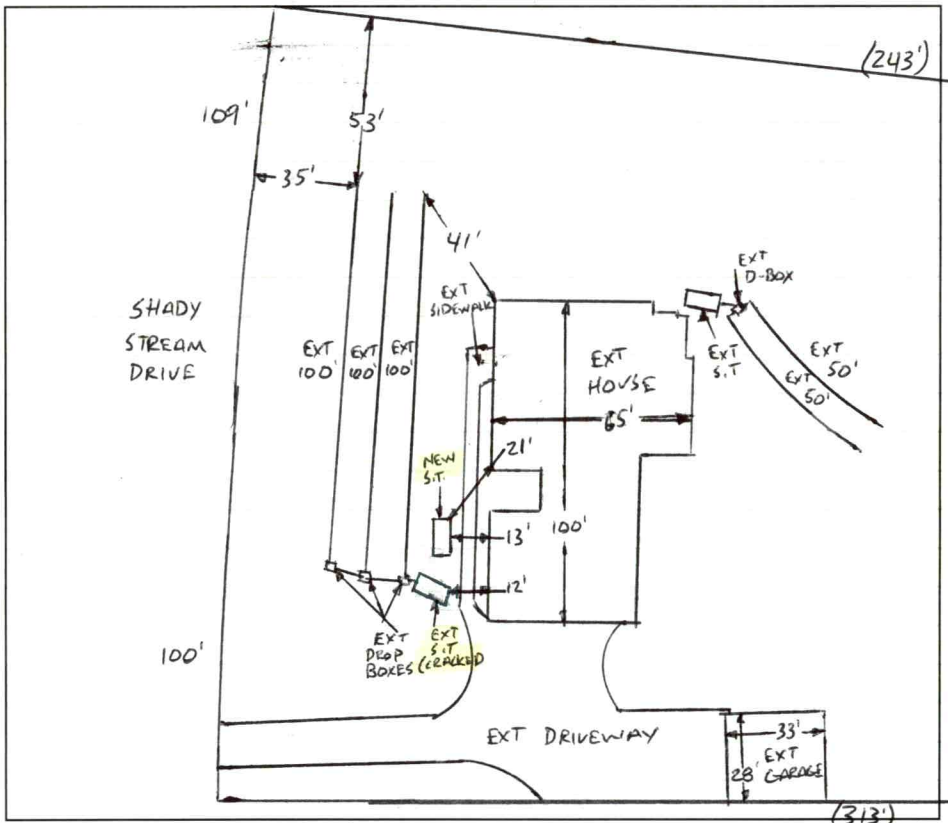

AS BUILT SKETCH

FOR SEPTIC FINAL INSPECTION CALL: 704-664-3703 between 8am-9am

the day the inspection is needed. Be sure to speak with an inspector to confirm your time.

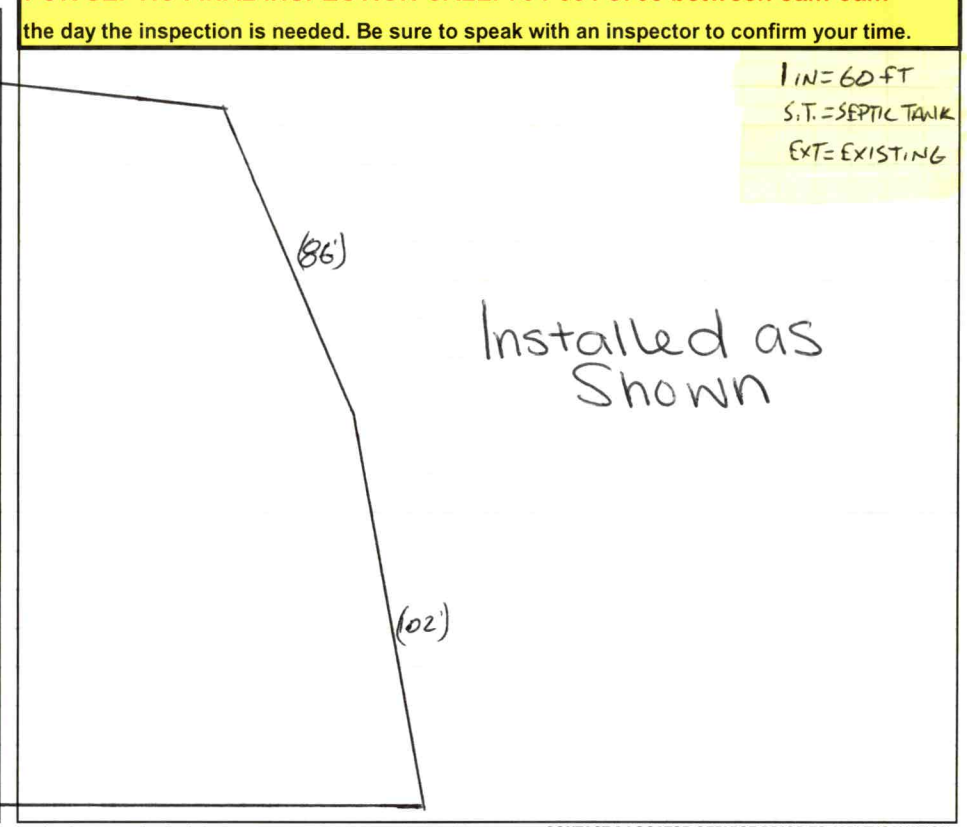

Permit can be suspended or revoked if any false information is supplied toward securing the permit / any unauthorized changes are made to the site / any unauthorized changes are made in the installation of the system. **CONTACT A LOCATOR SERVICE PRIOR TO ANY EXCAVATION**

☐ **IMPROVEMENT PERMIT** ***with plat*** *valid without expiration.* ☑ **IMPROVEMENT PERMIT** ***with site plan*** *valid for 60 mos.* ☑ **AUTHORIZATION TO CONSTRUCT** *valid for period equal to IMPROVEMENT PERMIT--not to exceed 60 mo.*

Owner / Applicant Signature: ONLINE SIGNATURE Date: — Installed by: Lentz

IMPROVEMENT PERMIT by: Bryant C. White ✓ Date: 6-12-2024 OPERATION PERMIT by: Sydney Holland ✓ Date: 7/11/24

AUTHORIZATION TO CONSTRUCT by: Bryant C. White ✓ Date: 6-12-2024 Existing System Inspected by: Date:

Item	Date	Initials
Drain Lines Checked		
Tanks Checked		
Pressure Manifold or Valve Box Checked		
Pressure Head Set		
Electrical Checked		
Floats Set		
Alarm Checked		
Maintenance Contract Needed? Y / N		
Comments:		

Repairs Only	
	State Code
Failing System Code	
Type of Distribution	G or P
Type of Failure/Malfunction	
Primary Cause of Failure/Malfunction	
Age of System? _____	
Initial or Repair? _____	

PERMIT SNAPSHOT REPORT OSWP-2024-54656 FOR IREDELL COUNTY

Permit Type	Environmental Health OSWP	**Project:**		**App Date:**	05/31/2024
Work Class:	EH Septic Permit	**District:**	Iredell County	**Exp Date:**	NOT AVAILABLE
Status:	PRIORITY PERMIT	**Square Feet:**	0.00	**Completed:**	NOT COMPLETED
Valuation:	$0.00	**Assigned To:**	White, Bryant	**Approval Expire Date:**	

Description: PRIORITY PERMIT -- REPAIR The septic tank is cracked. The septic tank is uncovered and visible. This property has two septic systems, in the front and back of the house. This application is for the front system.

Parcel: 4765664226.000 Main	**Address:** 162 Shady Stream Dr Statesville, NC 28625 Main	**Zone:** R-20(Suburban Residential District)

Property Owner
Sandra Flowers
Home: (704) 906-9549

Applicant/Authorized Agent
Jeanie Lentz
463 Lentz Road
Statesville, NC 28625

Permit Custom Fields

How is your site plan being submitted	Custom Site Plan	Septic Application/Permit Type	Repair	Does the site contain any jurisdictional wetlands	No
Non-domestic Sewage Generated	No	Other Public Agency	No	All proposed structure dimensions	N/A
What are the proposed structures	Other Addition/Structure	Maximum Number of Bedrooms	3	If other Addition/Structure, please explain	
Number of Occupants	2	Foundation Type	Basement with Plumbing	Water Supply	Other Public Water
Desired Septic System Type	No Preference	If other septic system type, please explain		Pump Make	
# of Nitrification Fields		Model		Serial #	
System Description		Repair System Description		Comments/Conditions	
Permit type(s)	Authorization to Construct	Additional Unique Setbacks Apply	No		

Attachment File Name	Added On	Added By	Attachment Group	Notes
Signature_Jeanie_Lentz_5/31/2024.jpg	05/31/2024 15:32	Lentz, Jeanie		Uploaded via CSS
162 Shady Stream Site Plan_v1.pdf	05/31/2024 16:16	Lentz, Jeanie	Available Online	
162_Shady_Stream_Drive_-_Authorize_Legal_Representative-sflowers704_gmail.com_v1.pdf	05/31/2024 16:16	Lentz, Jeanie	Available Online	

Workflow Step / Action Name	Action Type	Start Date	End Date
Application Completeness Check v.1		05/31/2024 16:16	05/31/2024 16:16
Confirm application complete v.1	Generic Action		05/31/2024 16:16
~~**Zoning Review v.1**~~			05/31/2024 16:16
~~Floodplain Admin Overview v.1~~	Task		05/31/2024 16:16
~~Issue Invoice v.1~~	Generic Action		05/31/2024 16:16
~~Fees Paid v.1~~	Generic Action		05/31/2024 16:16
Fees v.1			
Issue Invoice v.1	Generic Action		
Fees Paid v.1	Generic Action		
Lot Readiness Verification v.1			
OSWP Septic Preliminary Site Visit v.1	Inspection		

PERMIT SNAPSHOT REPORT (OSWP-2024-54656)

OSWP Site Evaluation v.1	Inspection
Issue Improvement Permit v.1	
Issue Invoice v.1	Generic Action
Fees Paid v.1	Generic Action
Issue Permit v.1	Generic Action
Permit Completion Process v.1	
Authorization to Construct Permit v.1	Create Sub Permit
Issue Authorization to Construct v.1	Generic Action