IREDELL COUNTY HEALTH DEPARTMENT

STATESVILLE 704-878-5305 MOORESVILLE 704-664-5281

IMPROVEMENT PERMIT / AUTHORIZATION TO CONSTRUCT / OPERATION PERMIT / EXISTING SYSTEM INSPECTION

PERMIT# 128792 PIN# 4765667 ~~197~~ ~~310~~ 197 DATE 8-1-05

OWNER OR CONTRACTOR Old Southern Development, Inc. PHONE: Business 704-902-2057 Home

ADDRESS 830 Big Indian Loop

LOCATION Hwy 64E, TL River Hill, TR Oak Haven, TL Shady Stream Dr, on right

SUBDIVISION Country Wood BLOCK / SECTION 0.531 ~~5A~~ ~~5A~~ ~~5A~~ 5A AREA SITE CLASS PS DESIGN FLOW 360gpd L.T.A.R. .3

Septic Tank: 1000 Gallons; STB 1012 Date 6-14-05

Pump Tank: Gallons; PT Date

Pump Make: Model Serial No.

Nitrification Field: No Fields Square Feet 1200 Linear Feet 300

No Lines 3 Trench Width 36" Max Trench Bottom Depth 36" Gravel Depth N/A

☒ New System ☐ Repair System Type: I, II, III, IV, V, VI

System Description: 25% red., gravity

Repair System Description: 25% red, pump

Maintenance Agreement Required: ☐ Yes ☒ No

☒ House/Mod. Home No. Bedrooms 3

☐ Mobile Home No. Bathrooms

☐ Business No. Employees

☐ Other

☐ Slab ☒ Crawl Space ☐ Basement w/plumbing ☐ Basement wo/plumbing


Water Supply: ☐ Individual ☒ Public ☐ Community

Comments:/Conditions:


Comments:/Conditions: SEPTIC TANK WITH MARKER INSTALLED USING "TUFTITE" FITTER

1" = 50'

INITIAL SITE SKETCH

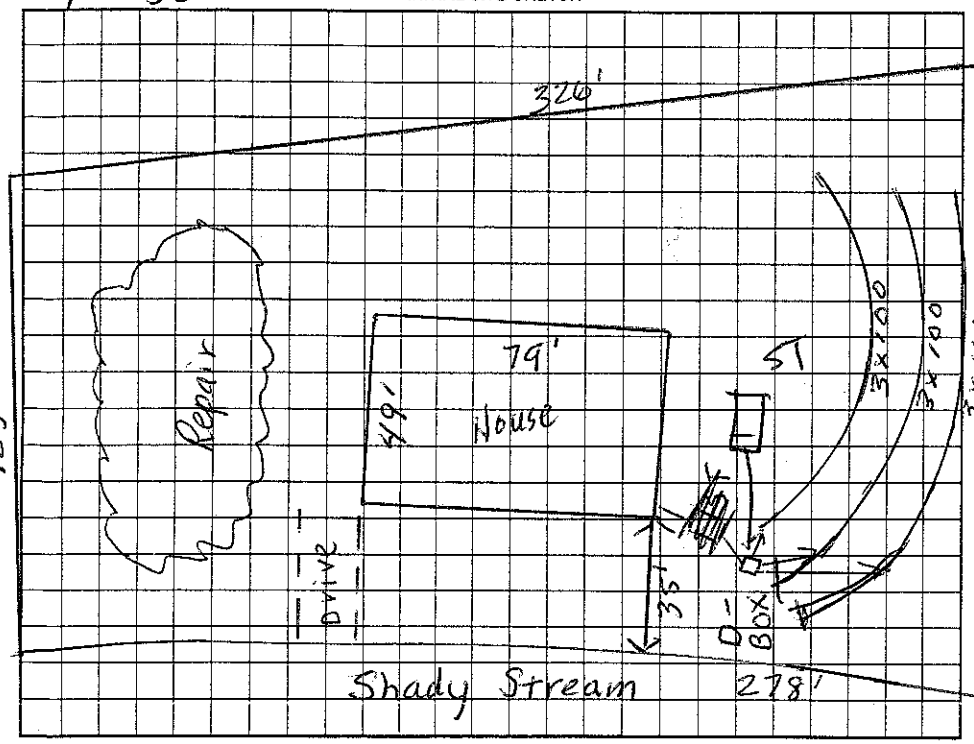

AS BUILT SKETCH

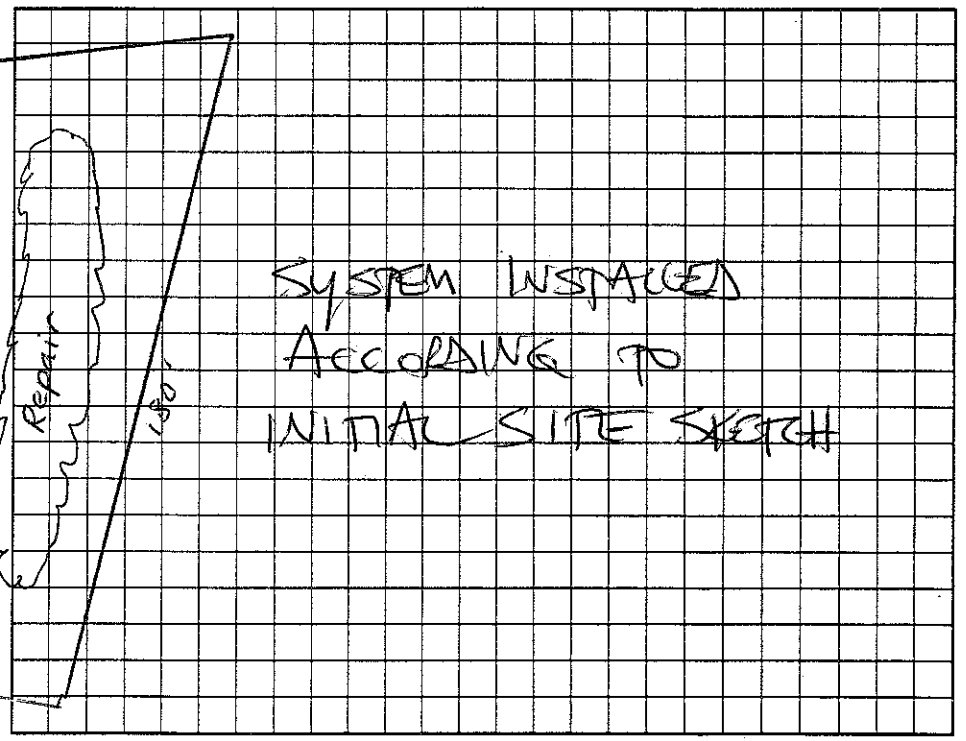

Permit can be suspended or revoked if any false information is supplied toward securing the permit/any unauthorized changes are made to the site/any unauthorized changes are made in the installation of the system. Improvement Permit with plat valid without expiration. Improvement Permit with site plan valid for sixty months. Authorization to Construct is valid for a period equal to that of Improvement Permit – not to exceed sixty months.

Signed: Ronnie Braswell date 8-16-05 Installed by: Tommy Frye

Improvement Permit by: Judy Melville date 8-1-05 Operation Permit by: Steve Herrick date 2-24-06

Authorization to Construct by: Judy Melville date 8-1-05 Existing System Inspection by: date

HEALTH DEPT. COPY: WHITE OWNER COPY (FINAL): YELLOW OWNER COPY (INITIAL): PINK