IREDELL COUNTY HEALTH DEPARTMENT

STATESVILLE 704-878-5305 MOORESVILLE 704-664-5281

IMPROVEMENT PERMIT / CERTIFICATE OF COMPLETION / OPERATION PERMIT / EXISTING SYSTEM INSPECTION

PROPERTY DESCRIPTION NO. 19221 DATE 9-18-96 TAX MAP NO. 11E-2-A-61+62 Watershed: ☐ Yes ☑ No

OWNER OR CONTRACTOR John T. Baker PHONE: Business Home 871-2159

ADDRESS 1007-3 Foxcroft Ln Statesville

LOCATION 64E TL Riverhill Rd TR Country Woods

SUBDIVISION Country Woods BLOCK / SECTION LOT 61+62 LOT AREA 1 acre SITE CLASS. P5 DESIGN FLOW 360 L.T.A.R. .3

Septic Tank: 1000 Gallons; STB 794 Date 3-23-98

Pump Tank: 1000 Gallons; PT 27 Date 4-15-98

Pump Make: Goulds Model WE05S11H Serial No. M9768612

Nitrification Field: No Fields 1 Square Feet 900 Linear Feet 300

No Lines 4 Trench Width 36" Max Trench Bottom Depth 24" Gravel Depth N/A

☑ New System ☐ Repair System Type: I, II, III, IV, V, VI

System Description: Pump To Chambers

Repair System Description: LPP

Maintenance Agreement Required: ☐ Yes ☑ No

☑ House/Mod. Home No. Bedrooms 3

☐ Mobile Home No. Bathrooms 2

☐ Business No. Employees

☐ Other

☐ Slab ☐ Crawl Space ☑ Basement w/plumbing ☐ Basement wo/plumbing


Water Supply: ☐ Individual ☐ Community ☑ Public

Comments:

See Attached Sheets for Pump Tank Pressure manifold & Clean out which become part of this permit.

Comments:

INITIAL SITE SKETCH

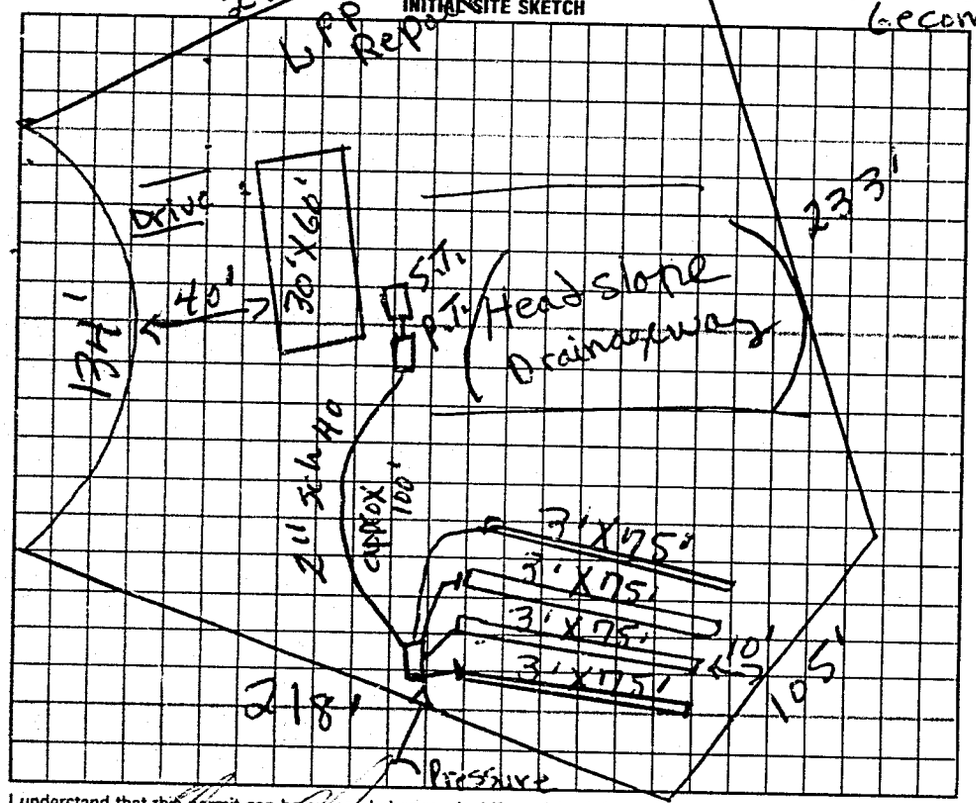

AS BUILT SKETCH

Same as initial Sketch

I understand that this permit can be suspended or revoked if any false information is supplied toward securing the permit/any unauthorized changes are made to the site/any unauthorized changes are made in the installation of the system.

Signed:

Improvement Permit by: authorization to cover R.C. Moore date 9-18-96

Existing System Inspection by R.C. Moore date 9-18-96

Installed by: Atlantic Grating

Certificate of Completion by: date

Operation Permit by: R.C. Moore date 8-12-98

HEALTH DEPT. COPY: WHITE INSPECTION COPY (FINAL): GREEN OWNER COPY (FINAL): YELLOW INSPECTION COPY (INITIAL): PINK OWNER COPY (INITIAL): GOLD

Authorization to cover EXPIRES 60 DAYS FROM ISSUE