IREDELL COUNTY HEALTH DEPARTMENT

STATESVILLE 704-878-5305 MOORESVILLE 704-664-5281

IMPROVEMENT PERMIT / AUTHORIZATION TO CONSTRUCT / OPERATION PERMIT / EXISTING SYSTEM INSPECTION

PERMIT# 075893 PIN# 4765670220 DATE 8-13-98

OWNER OR CONTRACTOR Kathleen Ellis PHONE: Business Home 873-1044

ADDRESS River Hill Rd Statesville

LOCATION 64E To River Hill Rd TR Ellis IR Fraley 8th Left

SUBDIVISION East MHP BLOCK / SECTION LOT 24 LOT AREA .8 SITE CLASS. DESIGN FLOW L.T.A.R.

Septic Tank: Gallons; STB Date

Pump Tank: Gallons; PT Date

Pump Make: Model Serial No.

Nitrification Field: No Fields Square Feet Linear Feet

No Lines Trench Width Max Trench Bottom Depth Gravel Depth

☐ New System ☐ Repair System Type: I, II, III, IV, V, VI

System Description:

Repair System Description:

Maintenance Agreement Required: ☐ Yes ☐ No

☐ House/Mod. Home ☒ Mobile Home ☐ Business ☐ Other

No. Bedrooms 3 No. Bathrooms 2 No. Employees

☐ Slab ☒ Crawl Space ☐ Basement w/plumbing ☐ Basement wo/plumbing

Water Supply: ☐ Individual ☒ Public ☐ Community


Comments:/Conditions:

Comments:/Conditions:

Existing System Check
Keep Fowlers 25 ft from system

INITIAL SITE SKETCH

AS BUILT SKETCH

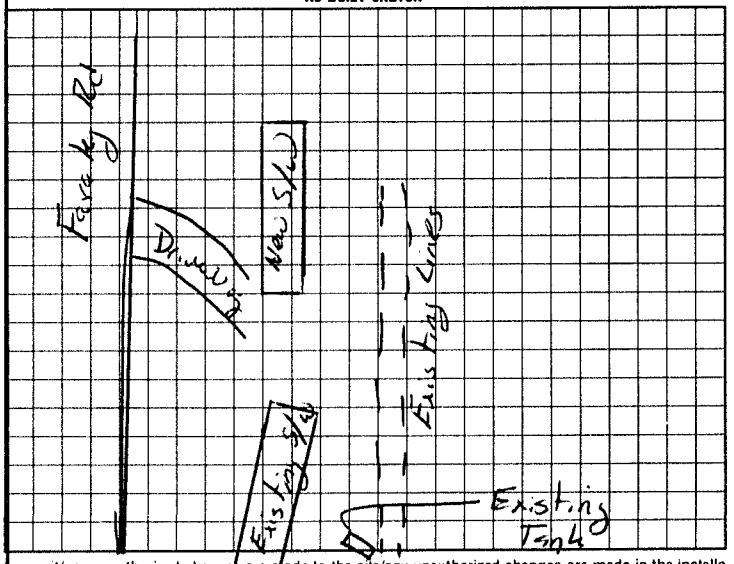

I understand that this permit can be suspended or revoked if any false information is supplied toward securing the permit/any unauthorized changes are made to the site/any unauthorized changes are made in the installation of the system. Improvement Permit with plat valid without expiration. Improvement Permit with site plan valid for sixty months. Authorization to Construct is valid for a period equal to that of Improvement Permit – not to exceed sixty months.

Signed: date

Improvement Permit by: date

Authorization to Construct by: date

Installed by:

Operation Permit by: date

Existing System Inspection by: Mark C. Outlaw date 8-13-98

HEALTH DEPT. COPY: WHITE INSPECTION COPY (FINAL): GREEN OWNER COPY (FINAL): YELLOW INSPECTION COPY (INITIAL): PINK OWNER COPY (INITIAL): GOLD