IREDELL COUNTY HEALTH DEPARTMENT

Statesville Phone TR 3-7271 Mooresville Phone No. 664-5281

PERMIT TO INSTALL SEPTIC TANK

Permit No. 20 EAST TRAILER PARK Permit Date 10-24 1972

Owner A.M. Gurley & J. Lyon Ellis Jr Address Statesville, NC.

Installed By Lackey Bros. Address Stony Point, NC.


Location of Property 64 E - Left on River Hill Rd - Go 1 mile - Trailer Park on Rt.

Tank		Capacity		Length of Lines		Fixtures	
Block	( )	1000	( )	225'	( )	No. of Baths	(3)
Precast	(✓)	1250	(✓)	250'	( )	Dishwasher	( )
		1500	( )	Other 400		Garbage Grdr.	( )
		Other				Other	

NOTIFY HEALTH DEPARTMENT AT LEAST EIGHT HOURS BEFORE TANK IS TO BE INSPECTED.

Final Inspection 10-24 1972 Approved (✓) Disapprcved ( )

Remarks IREDELL WATER CORP.

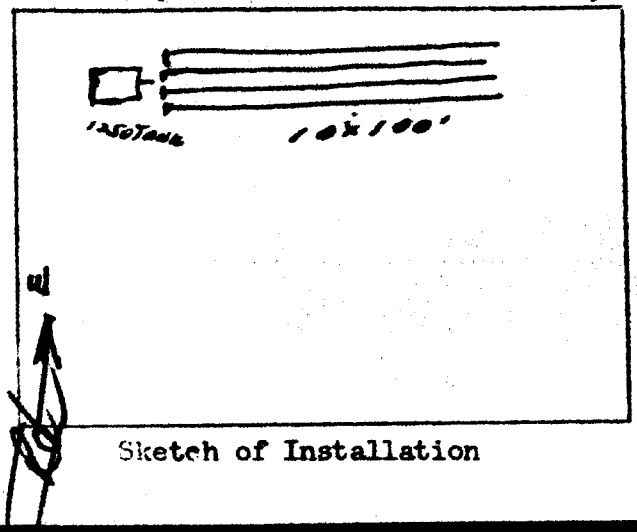

Sketch of Installation

Sanitarian