IREDELL COUNTY HEALTH DEPARTMENT

Statesville Phone TR 3-7271 Mooresville Phone No. 664-5281

PERMIT TO INSTALL SEPTIC TANK

Permit No. / Permit Date 9-12 1973

Owner E. Iredell Trailer Park Address Statesville N.C.

Installed By Lackey Bro Address Stony Point N.C.


Location of Property Hwy 64 E. To Sharps Gro Tch. on River Hill Rd # 2166 - Go 1 Mile. Trailer Park on L. This is last tank on R. Near Woods

Tank		Capacity		Length of Lines		Fixtures	
Block	( )	1000	( )	225'	( )	No. of Baths	( )
Precast	(✓)	1250	(✓)	250'	( )	Dishwasher	( )
		1500	( )	Other 400		Garbage Grdr.	( )
		Other				Other	

NOTIFY HEALTH DEPARTMENT AT LEAST EIGHT HOURS BEFORE TANK IS TO BE INSPECTED.

Final Inspection 9-12 1973 Approved (✓) Disapproved ( )

Remarks Iredell Water Corp.

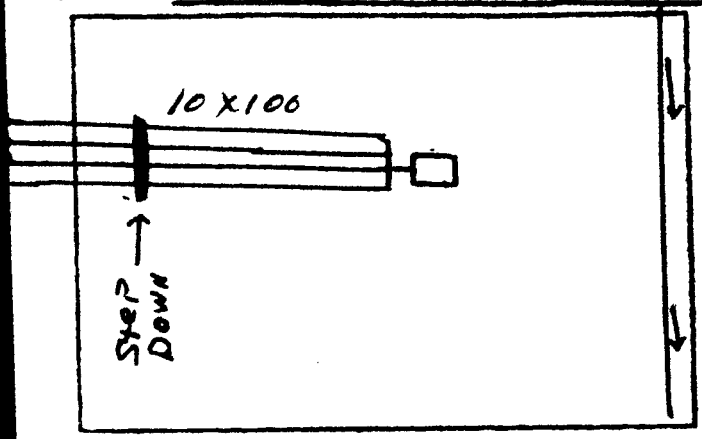

Sketch of Installation

Trailer Not on Lot at time of inspection

E. G. Stevenson

Sanitarian