IREDELL COUNTY HEALTH DEPARTMENT

Statesville Phone TR 3-7271 Mooresville Phone No. 664-5281

PERMIT TO INSTALL SEPTIC TANK

Permit No. 192 Permit Date 4-12 1973

Owner EAST IREDELL Mobile Park Address STATESVILLE, N.C.

Installed By LACKEY Bros Address Stony Point, N.C.

Location of Property 64-E LEFT ON River Hill Rd.


60 1/10 MILE TRAILER PARK ON Rt.

| Tank | | Capacity | | Length of Lines | | Fixtures 3 TRAILERS | |
|---|---|---|---|---|---|---|---|
| Block | ( ) | 1000 | ( ) | 225' | ( ) | No. of Baths | ( ) |
| Precast | (✓) | 1250 | (✓) | 250' | ( ) | Dishwasher | ( ) |
| | | 1500 | ( ) | Other 400 | | Garbage Grdr. | ( ) |
| | | Other | | | | Other | |

NOTIFY HEALTH DEPARTMENT AT LEAST EIGHT HOURS BEFORE TANK IS TO BE INSPECTED.

Final Inspection 4-12 1973 Approved (✓) Disapproved ( )

Remarks Iredell Water Corp.

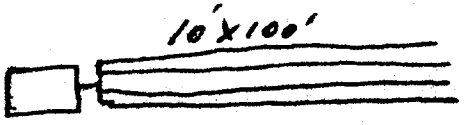


Sketch of Installation

Sanitarian