IREDELL COUNTY HEALTH DEPARTMENT

Statesville Phone TR 3-7271 Mooresville Phone No. 664-5281

PERMIT TO INSTALL SEPTIC TANK

Permit No. 114 Permit Date 2-16 1973

Owner EAST IREDELL MOBILE PARK Address STATESVILLE, NC.

Installed By LACKEY BROS Address STONY POINT, NC.


Location of Property 64 E. LEFT ON RIVER HILL RD - GO 1 MILE - PARK ON RT.

Tank		Capacity		Length of Lines		Fixtures 2 TRAILERS	
Block	( )	1000	( )	225'	( )	No. of Baths	( )
Precast	(✓)	1250	(✓)	250'	( )	Dishwasher	( )
		1500	( )	Other 400		Garbage Grdr.	( )
		Other				Other	

NOTIFY HEALTH DEPARTMENT AT LEAST EIGHT HOURS BEFORE TANK IS TO BE INSPECTED.

Final Inspection 2-16 1973 Approved (✓) Disapproved ( )

Remarks IREDELL WATER CORP.

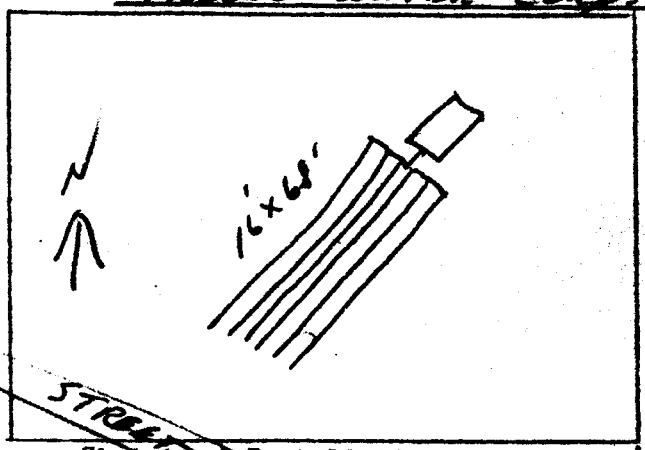

Sketch of Installation

Glenn Long

Sanitarian