IREDELL COUNTY HEALTH DEPARTMENT

Statesville Phone TR 3-7271 Mooresville Phone NO 3-1271

PERMIT TO INSTALL SEPTIC TANK

Permit No. 310 Permit Date _____ 19__

Owner East Iredell Lions Club Address Statesville NC

Installed By Floyd Adams Address Taylorsville


Location of Property Hwy 64E to River Hill Rd.
About 1½ miles on right

Tank		Capacity		Length of Lines		Fixtures	
Block	( )	~~1000~~	( )	225'	( )	No. of Baths	(2)
Precast	(✓)	1250	( )	250'	( )	Dishwasher	( )
		1500	( )	Other 325'		Garbage Grdr.	( )
		Other _____				Other Kitchen Facilities	

NOTIFY HEALTH DEPARTMENT AT LEAST EIGHT HOURS BEFORE TANK IS TO BE ~~INSPECTED~~.

Final Inspection 5-6- 1971 Approved (✓) Disapproved ( )

Remarks _____

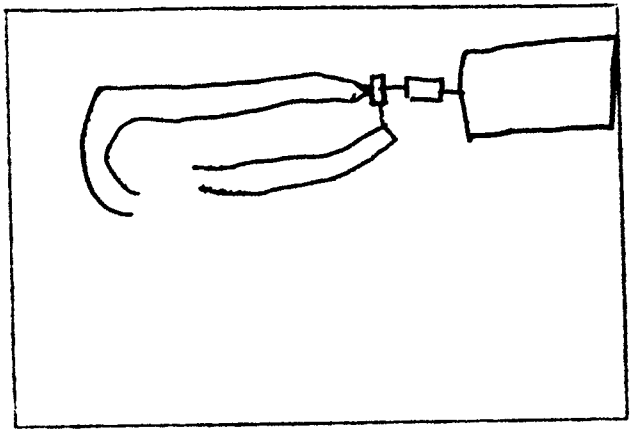

Sketch of Installation

Designed by R.W.J.

Cecil S. Hall

Sanitarian