IREDELL COUNTY HEALTH DEPARTMENT

STATESVILLE 704-878-5305 MOORESVILLE 704-664-5281

IMPROVEMENT PERMIT / CERTIFICATE OF COMPLETION / OPERATION PERMIT / EXISTING SYSTEM INSPECTION

PROPERTY DESCRIPTION NO. _____ DATE 8-5-93 TAX MAP NO. _____

OWNER OR CONTRACTOR Dan Dorby PHONE: Business _____ Home _____

ADDRESS _____

LOCATION 64E TL Riverhill Rd Past Lions Club 3rd Hse on Rt

SUBDIVISION _____ BLOCK / SECTION _____ LOT _____ LOT AREA _____ SITE CLASS. _____ L.T.A.R. _____

Water Supply: ☐ Individual ☐ Community ☑ Public

Septic Tank: Ex Gallons; STB _____ Date _____

Pump Tank: _____ Gallons; PT _____ Date _____

Nitrification Field: No Fields 1 Square Feet 600 Linear Feet 200

No Lines 2 Trench Width 36 Trench Depth 18&24 Gravel Depth 12

☐ New System ☑ Repair System Type: I, II, III, IV, V, VI

System Description: _____

Repair System Description: Conv. Gravity

Maintenance Agreement Required: ☐ Yes ☑ No

☑ House/Mod. Home No. Bedrooms _____ Garbage Disposal: ☐ Yes ☐ No

☐ Mobile Home No. Bathrooms _____ Auto. Dishwasher: ☐ Yes ☐ No


☐ Business No. Employees _____ Auto. Washing Machine: ☐ Yes ☐ No

☐ Other _____ Other _____

☐ Slab ☐ Crawl Space ☐ Basement w/plumbing ☐ Basement wo/plumbing

Comments _____

INITIAL SITE SKETCH

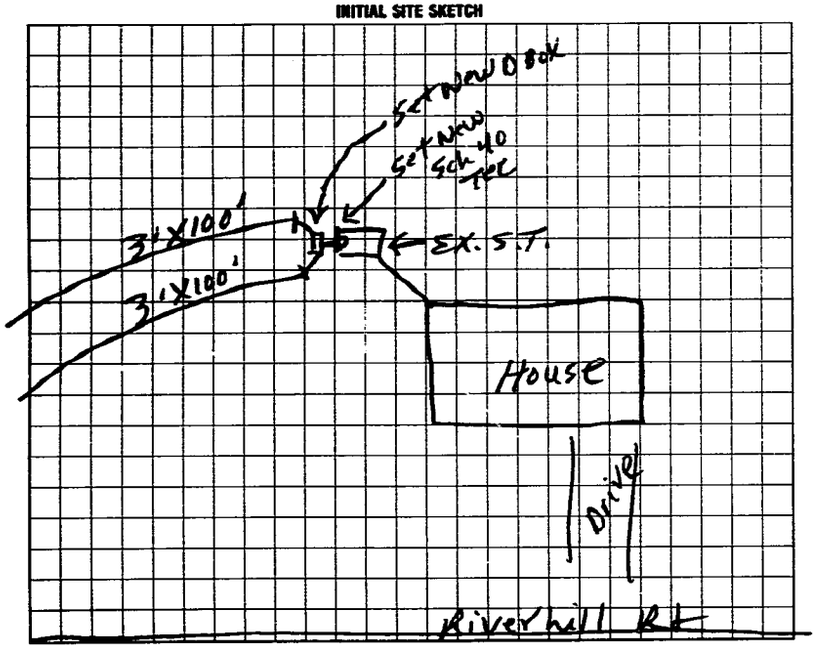

AS BUILT SKETCH

Same as initial Sketch

I understand that this permit can be suspended or revoked if any false information is supplied toward securing the permit/any unauthorized changes are made to the site/any unauthorized changes are made in the installation of the system. Improvement Permit is valid for 60 months from date of issuance.

Signed: X Roger M. Lipsey

Improvement Permit by: L. C. Moore date 8-5-93

Existing System Inspection by: _____ date _____

Installed by: AAA Enterprizes

Certificate of Completion by: L. C. Moore date 8-5-93

Operation Permit by: _____ date _____

HEALTH DEPT. COPY: WHITE INSPECTION COPY (FINAL): GREEN OWNER COPY (FINAL): YELLOW INSPECTION COPY (INITIAL): PINK OWNER COPY (INITIAL): GOLD