IREDELL COUNTY HEALTH DEPARTMENT

STATESVILLE 704-878-5305 MOORESVILLE 704-664-5281

IMPROVEMENT PERMIT / AUTHORIZATION TO CONSTRUCT / OPERATION PERMIT / EXISTING SYSTEM INSPECTION

PERMIT# 77249 PIN# 4765683729 DATE 10-30-98

OWNER OR CONTRACTOR Joseph Riccio PHONE: Business Home 871 9190

ADDRESS 2021 Sandy Ave Sta N.C. 28625

LOCATION Hwy 64 TR Riverhill Rd TR Easy livin Ln 1st Home RR

SUBDIVISION BLOCK / SECTION LOT LOT AREA .59 SITE CLASS: PS DESIGN FLOW 360 L.T.A.R. .33

Septic Tank: 1000 Gallons; STB 7794 Date 10-1-98

Pump Tank: Gallons; PT Date

Pump Make: Model Serial No.

Nitrification Field: No Fields 1 Square Feet 1080 Linear Feet 360

No Lines 4 Trench Width 36" Max Trench Bottom Depth 36" Gravel Depth 12"

☑ New System ☐ Repair System Type: I ◯ III, IV, V, VI

System Description: conv. Gravity

Repair System Description Gravity 25% Red

Maintenance Agreement Required: ☐ Yes ☐ No

☑ House/Mod. Home No. Bedrooms 3

☐ Mobile Home No. Bathrooms 2

☐ Business No. Employees


☐ Other

☐ Slab ☑ Crawl Space ☐ Basement w/plumbing ☐ Basement wo/plumbing

Water Supply: ☑ Individual ☐ Public ☐ Community


Comments:/Conditions:

INITIAL SITE SKETCH

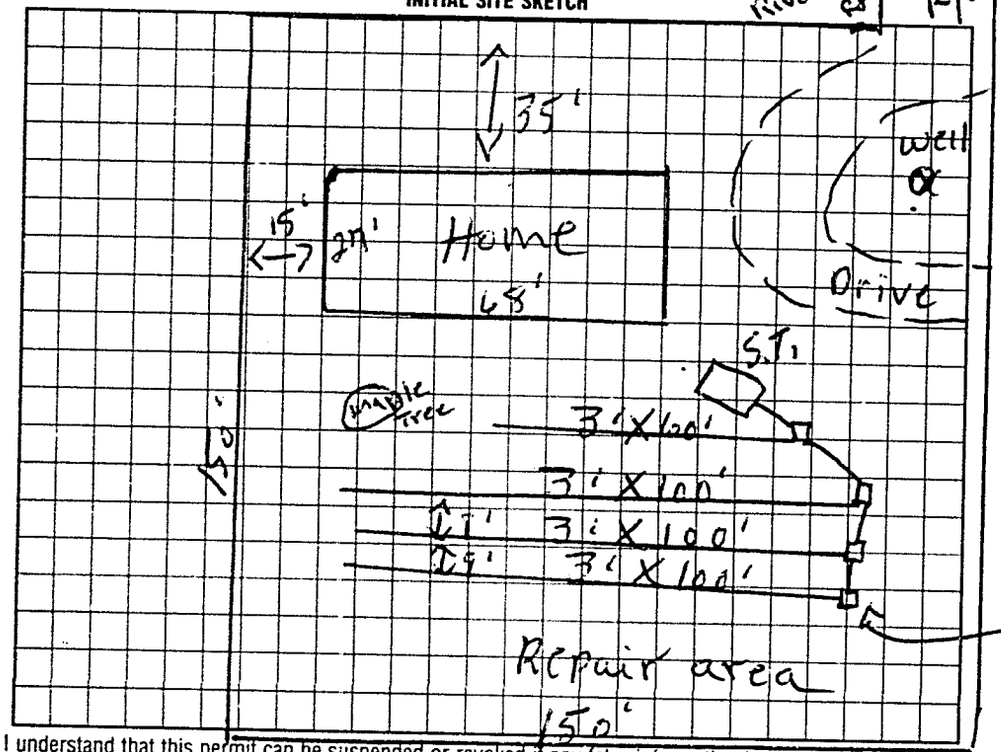

Comments:/Conditions:

AS BUILT SKETCH

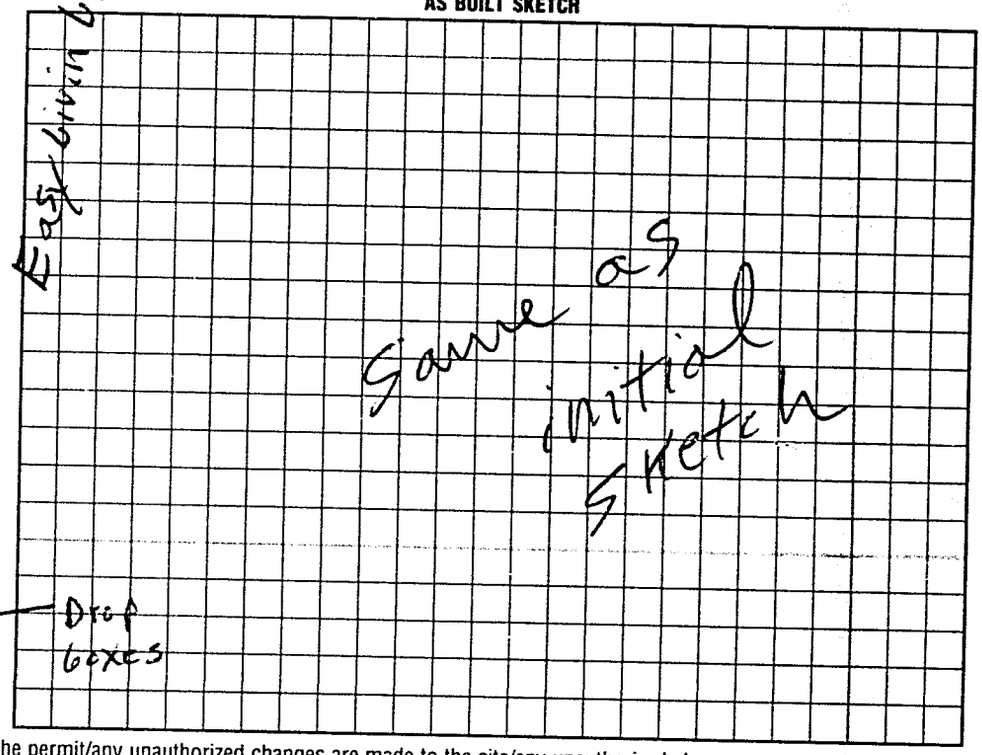

I understand that this permit can be suspended or revoked if any false information is supplied toward securing the permit/any unauthorized changes are made to the site/any unauthorized changes are made in the installation of the system. Improvement Permit with plat valid without expiration. Improvement Permit with site plan valid for sixty months. Authorization to Construct is valid for a period equal to that of Improvement Permit – not to exceed sixty months.

Signed: X Joseph A Riccio date Installed by: A. Cornelius Grading (mecklco)

Improvement Permit by: R.C. moore date 10-30-98 Operation Permit by: R.C. moore date 12-29-98

Authorization to Construct by: R.C. moore date 10-30-98 Existing System Inspection by: date

HEALTH DEPT COPY WHITE INSPECTION COPY (FINAL) GREEN OWNER COPY (FINAL) YELLOW INSPECTION COPY (INITIAL) PINK OWNER COPY (INITIAL) GOLD