IREDELL COUNTY HEALTH DEPARTMENT

Statesville Phone TR 3-7271 Mooresville Phone NO 3-1271

PERMIT TO INSTALL SEPTIC TANK

Permit No. 20 Permit Date 4-26 1972

Owner G.C. HENDRIX Address STATESVILLE, NC

Installed By ROBERT BOST Address STATESVILLE, NC


Location of Property #64 E (MOCKSVILLE RD) - TURN LEFT BEFORE SHARPES GRO. (RIVER HILL RD) GO 1½ MILES TRAILER BK. ON RT. PAST LIONS CLUB HOUSE -

Tank		Capacity		Length of Lines		Fixtures	
Block	( )	1000	(✓)	225'	(✓)	No. of Baths	(1)
Precast	(✓)	1250	( )	250'	( )	Dishwasher	( )
		1500	( )	Other		Garbage Grdr.	( )
		Other				Other	

NOTIFY HEALTH DEPARTMENT AT LEAST EIGHT HOURS BEFORE TANK IS TO BE INSPECTED.

Final Inspection 4-26 1972 Approved (✓) Disapproved ( )

Remarks ok mw

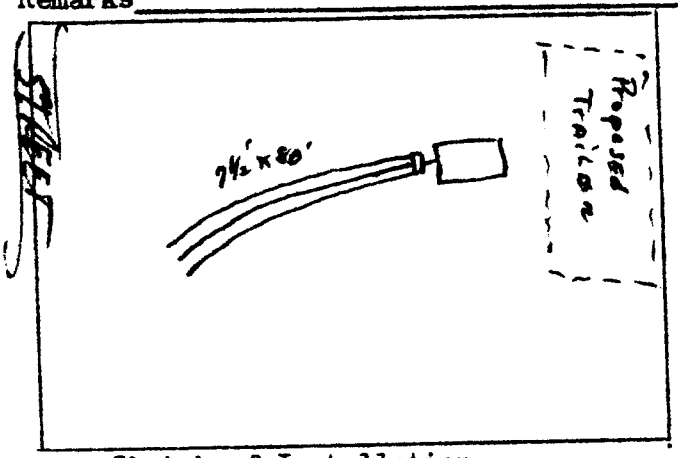

Sketch of Installation

Sanitarian