IREDELL COUNTY HEALTH DEPARTMENT

Statesville Phone TR 3-7271 Mooresville Phone NO 3-1271

PERMIT TO INSTALL SEPTIC TANK

Permit No. 156 Permit Date 7-7 1972

Owner May Propst Address Statesville N.C.

Installed By Max Propst Address Statesville, N.C.


Location of Property 64 E. Turn Left on Road #2166 (River View Rd) Go 1 1/10 Miles House on Right.

Tank		Capacity		Length of Lines		Fixtures	
Block	( )	1000	(✓)	225'	(✓)	No. of Baths	(1½)
Precast	(✓)	1250	( )	250'	( )	Dishwasher	( )
		1500	( )	Other		Garbage Grdr.	( )
		Other				Other	

NOTIFY HEALTH DEPARTMENT AT LEAST EIGHT HOURS BEFORE TANK IS TO BE INSPECTED.

Final Inspection 7-7 1972 Approved (✓) Disapproved ( )

Remarks IREDELL WATER CO-OP

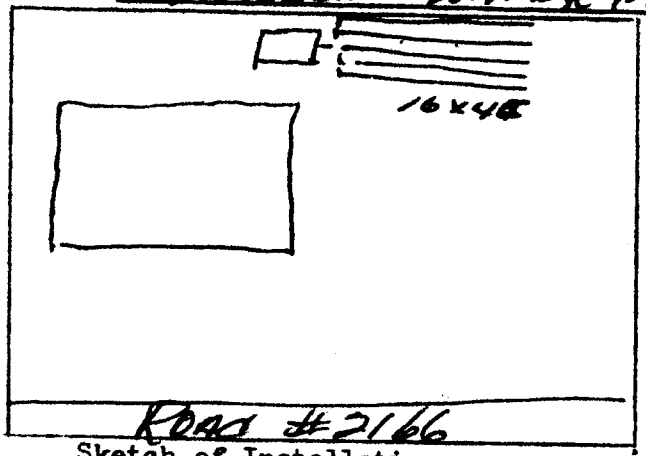

Road #2166

Sketch of Installation

Glenn Foster

Sanitarian