IREDELL COUNTY HEALTH DEPARTMENT

STATESVILLE 704-878-5305 MOORESVILLE 704-664-5281

IMPROVEMENT PERMIT / AUTHORIZATION TO CONSTRUCT / OPERATION PERMIT / EXISTING SYSTEM INSPECTION

PERMIT# 79323 PIN# 4765691851 DATE 3-29-99

OWNER OR CONTRACTOR Linda Wingler PHONE: Business 872 3205 Home

ADDRESS 419 Riverhill Rd

LOCATION 64 E to Riverhill Rd 1.2 miles on left

SUBDIVISION Majestic Acres BLOCK / SECTION LOT 3 LOT AREA 20,000 Sq' SITE CLASS PS DESIGN FLOW 360 L.T.A.R. 3

Septic Tank: 1800 Gallons; STB 1012 Date 3-22-99
Pump Tank: Gallons; PT Date
Pump Make: Model Serial No.
Nitrification Field: No Fields 1 Square Feet 900 Linear Feet 300
No Lines 4 Trench Width 36" Max Trench Bottom Depth 36" Gravel Depth N/A

(X) New System ( ) Repair System Type: I, II, III, IV, V, VI
System Description: Gravity 252 Rt
Repair System Description: Pump to panels
Maintenance Agreement Required: ( ) Yes (X) No
( ) Slab (X) Crawl Space ( ) Basement w/plumbing ( ) Basement wo/plumbing

( ) House/Mod. Home No. Bedrooms 3
(X) Mobile Home No. Bathrooms 2
( ) Business No. Employees
( ) Other


Water Supply: ( ) Individual (X) Public ( ) Community

Riverhill

Comments/Conditions:

Comments/Conditions: Check outlet Filter periodicly

INITIAL SITE SKETCH

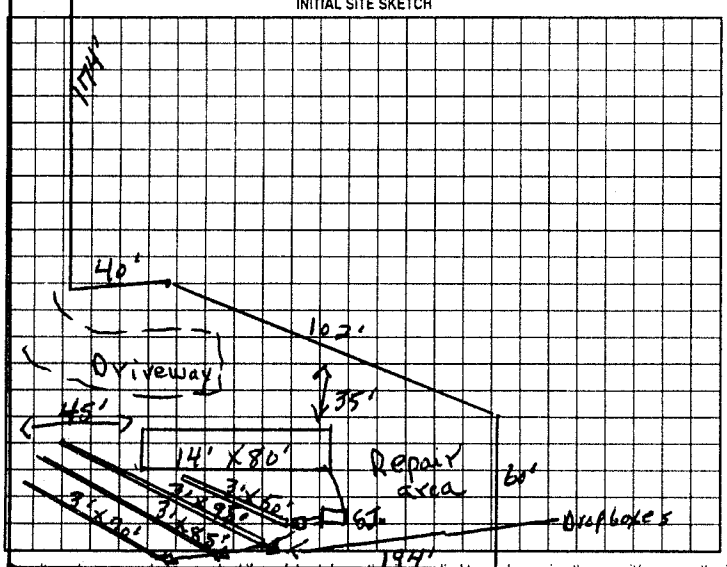

AS BUILT SKETCH

Same as initial sketch

209'

Permit can be suspended or revoked if any false information is supplied toward securing the permit/any unauthorized changes are made to the site/any unauthorized changes are made in the installation of the system. Improvement Permit with plat valid without expiration. Improvement Permit with site plan valid for sixty months. Authorization to Construct is valid for a period equal to that of Improvement Permit – not to exceed sixty months.

Signed: Linda Wingler date 4/9/99 Installed by: Donald Fuchs

Improvement Permit by: L.C. moore date 3-29-99 Operation Permit by: L.C. moore date 5-12-99

Authorization to Construct by: L.C. moore date 3-29-99 Existing System Inspection by: date

HEALTH DEPT COPY: WHITE OWNER COPY (FINAL) YELLOW OWNER COPY (INITIAL) PINK