4-25-96 Pd.#150 m.o 9:30 60341

IREDELL COUNTY HEALTH DEPARTMENT

STATESVILLE 704-878-5305 MOORESVILLE 704-664-5281

IMPROVEMENT PERMIT / CERTIFICATE OF COMPLETION / OPERATION PERMIT / EXISTING SYSTEM INSPECTION

PROPERTY DESCRIPTION NO. ~~4749~~ 060347 DATE 4-25-96 TAX MAP NO. 55-23-28 Watershed: ☐ Yes ☐ No

OWNER OR CONTRACTOR Allen D. Campbell PHONE: Business _____ Home 878-9129

ADDRESS 131 Woodview Dr. Statesville

LOCATION 64E TR Bell Fm TL Evergreen TR Birchwood TR Woodview 1000' Left

SUBDIVISION Sinbrook BLOCK / SECTION _____ LOT 28 LOT AREA .5 Acres SITE CLASS PS DESIGN FLOW 240 L.T.A.R. 13

Septic Tank: 1000 Gallons; STB 1012 Date 7-26-96

Pump Tank: 1000 Gallons; PT 1169 Date 7-26-96

Pump Make: Gould Model WE05T1H Serial No. 4-960166

Nitrification Field: No Fields 1 Square Feet 800 Linear Feet 800

No Lines 3 Trench Width 36" Max Trench Bottom Depth 36" Gravel Depth N/A

☐ New System ☐ Repair System Type: I, II, III, IV, V, VI

System Description: Pump To Chambers

Repair System Description: " " Panels

Maintenance Agreement Required: ☐ Yes ☒ No

☒ House/Mod. Home No. Bedrooms 3

☐ Mobile Home No. Bathrooms 2

☐ Business No. Employees ____

☐ Other _____

☐ Slab ☒ Crawl Space ☐ Basement w/plumbing ☐ Basement wo/plumbing

Water Supply: ☐ Individual ☐ Community ☒ Public

Comments:


See attached Sheets for Pump Tank, manifold & chamber Clean out which are Part of this Permit

Comments:


Checked S.T. P.T. Flow Rate Drain lines Clean out 10-30-96 JCM

Final Alarm ck & Landscape 5-13-97

INITIAL SITE SKETCH

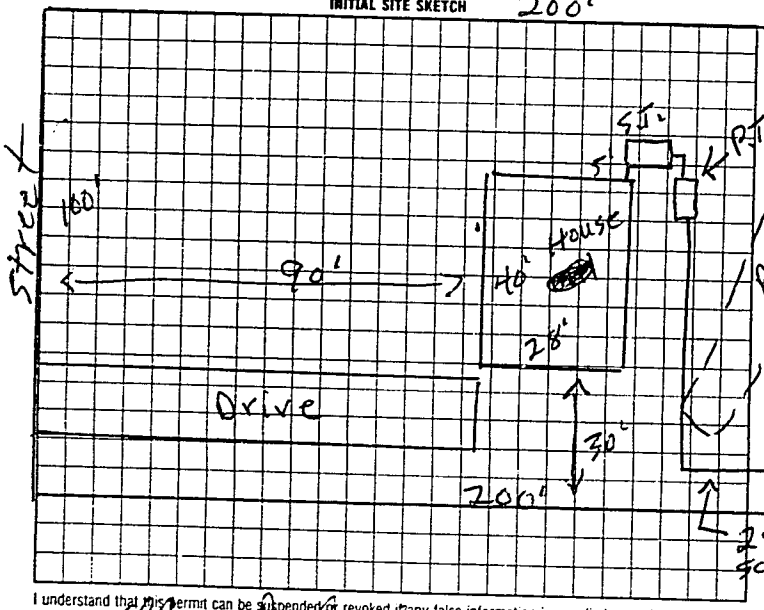

AS BUILT SKETCH

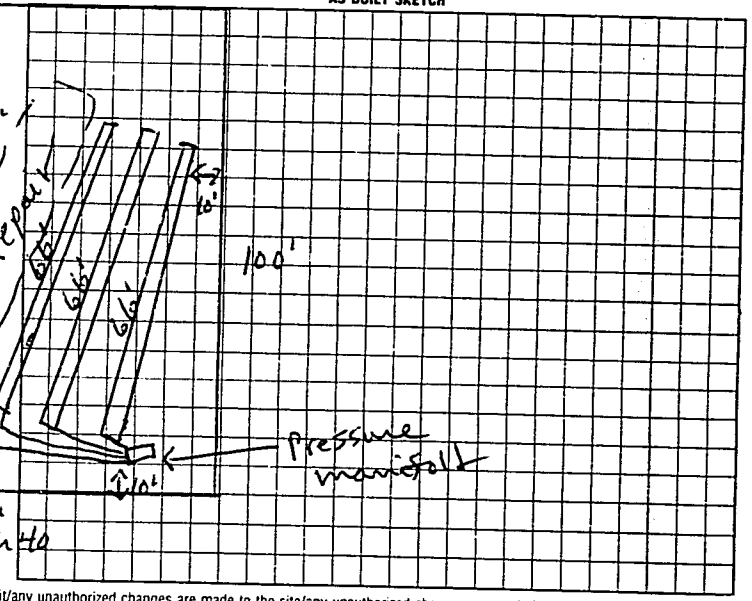

I understand that this permit can be suspended or revoked if any false information is supplied toward securing the permit/any unauthorized changes are made to the site/any unauthorized changes are made in the installation of the system.

Signed: Allen D. Campbell

Improvement Permit by: E.C. Moore date 4-25-96

~~Authorization~~ Existing System Inspection by: E.C. Moore date 4-25-96

to COVER HEALTH DEPT COPY WHITE INSPECTION COPY (FINAL) GREEN OWNER COPY (FINAL) YELLOW

Installed by: Donald Tatum

Certificate of Completion by: _____ date _____

Operation Permit by: E.C. Moore date 5-13-97

INSPECTION COPY (INITIAL) PINK OWNER COPY (INITIAL) GOLD

authorization to count EXPIRES 60 MOS - FROM ISSUE