IREDELL COUNTY HEALTH DEPARTMENT

STATESVILLE 704-878-5305 MOORESVILLE 704-664-5281

IMPROVEMENT PERMIT / AUTHORIZATION TO CONSTRUCT / OPERATION PERMIT / EXISTING SYSTEM INSPECTION

PERMIT# 74816 PIN# 4765 71 3088

OWNER OR CONTRACTOR A. J. Building Co. PHONE: Business 871 0940 Home DATE 7-17-98

ADDRESS 146 Hunter Ridge Ln

LOCATION Bell Fm Rd TL Evergreen TR Birchwood TR Woodview 2nd lt 1 left

SUBDIVISION Sunbrook BLOCK / SECTION II LOT 24 LOT AREA 100'X200' SITE CLASS PS DESIGN FLOW 360 L.T.A.R. .3

Septic Tank: 1000 Gallons; STB 1017 Date 7-28-98

Pump Tank: 1000 Gallons; PT 17 Date 7-1-98

Pump Make: Hydromatic Model SHEF 52-A Serial No.

Nitrification Field: No Fields 1 Square Feet 900 Linear Feet 300

No Lines 7 Trench Width 36" Max Trench Bottom Depth 36" Gravel Depth

☑ New System ☐ Repair System Type: I, II, III, IV, V, VI

System Description: Pump To 2580 Rct. system

Repair System Description: " " panels

Maintenance Agreement Required: ☐ Yes ☑ No

☑ House/Mod. Home ☐ Mobile Home ☐ Business ☐ Other

No. Bedrooms 3 No. Bathrooms 2 No. Employees

☐ Slab ☑ Crawl Space ☐ Basement w/plumbing ☐ Basement wo/plumbing


Water Supply: ☐ Individual ☑ Public ☐ Community

Comments:/Conditions:


Replaces Permit Issued 6-22-98

Comments:/Conditions:

INITIAL SITE SKETCH

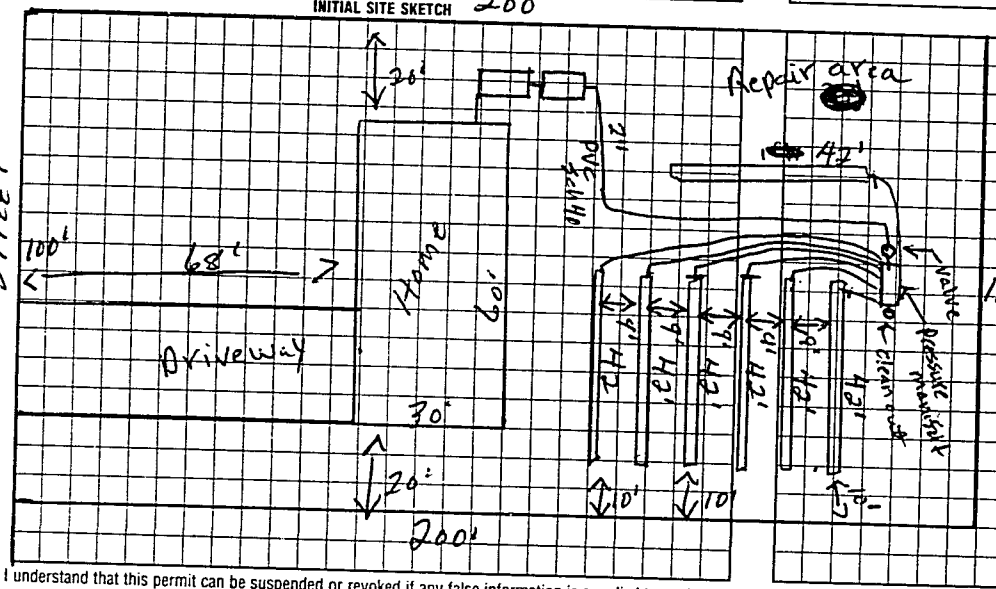

AS BUILT SKETCH

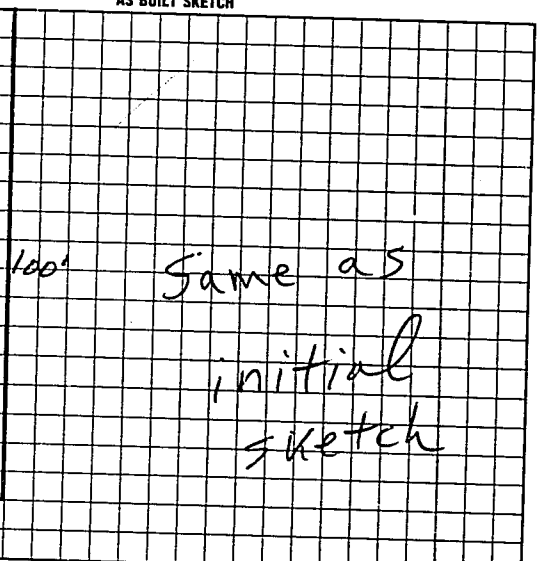

Street

I understand that this permit can be suspended or revoked if any false information is supplied toward securing the permit/any unauthorized changes are made to the site/any unauthorized changes are made in the installation of the system. Improvement Permit with plat valid without expiration. Improvement Permit with site plan valid for sixty months. Authorization to Construct is valid for a period equal to that of Improvement Permit – not to exceed sixty months.

Signed: Jeffrey E. Whitlow date

Improvement Permit by: J. C. Moore date 7-17-98

Authorization to Construct by: J. C. Moore date 7-17-98

Installed by: Steve Jordan

Operation Permit by: J. C. Moore date 11-23-98

Existing System Inspection by: date

HEALTH DEPT. COPY WHITE INSPECTION COPY (FINAL) GREEN OWNER COPY (FINAL) YELLOW INSPECTION COPY (PARTIAL) PINK OWNER COPY (PARTIAL)