IREDELL COUNTY HEALTH DEPARTMENT

STATESVILLE 704-878-5305 MOORESVILLE 704-664-5281 (C1)

IMPROVEMENT PERMIT / AUTHORIZATION TO CONSTRUCT / OPERATION PERMIT / EXISTING SYSTEM INSPECTION

PERMIT# 140786 PIN# 4765-70-9618 DATE 3-12-07

OWNER OR APPLICANT JUNIOUS W. DOBBINS PHONE: Business _____ Home 704-873-9636

ADDRESS 112 CONE LANE, STATESVILLE NC 28625

LOCATION US 64 EAST, TR LONE PINE ROAD TR CONE LANE 2ND DRIVE ON RIGHT

SUBDIVISION _____ BLOCK / SECTION _____ LOT _____ LOT AREA 13.94 ACRES SITE CLASS. PS DESIGN FLOW 240 L.T.A.R. EXISTING

Septic Tank: 1000 Gallons; STB _____ Date _____

Pump Tank: _____ Gallons; PT _____ Date _____

Pump Make: _____ Model _____ Serial No. _____

Nitrification Field: No Fields 1 Square Feet 900 Linear Feet 300

No Lines THREE Trench Width 36" Max Trench Bottom Depth 36" Gravel Depth 12

☐ New System ☐ Repair ☐ Expansion System Type: I II III IV V VI

System Description: CONVENTIONAL GRAVITY

Repair System Description: _____

Maintenance Agreement Required: ☐ Yes ☒ No

☐ Gravity ☐ Pressure

☐ House/Mod. Home ☒ Mobile Home ☐ Business ☐ Other

No. Bedrooms 2 No. Persons _____ No. Employees _____

Water Supply: ☒ Individual ☐ Public ☐ Community


☐ Slab ☒ Crawl Space ☐ Basement w/plumbing ☐ Basement wo/plumbing

Comments:/Conditions:

Comments:/Conditions:

INITIAL SITE SKETCH

AS BUILT SKETCH

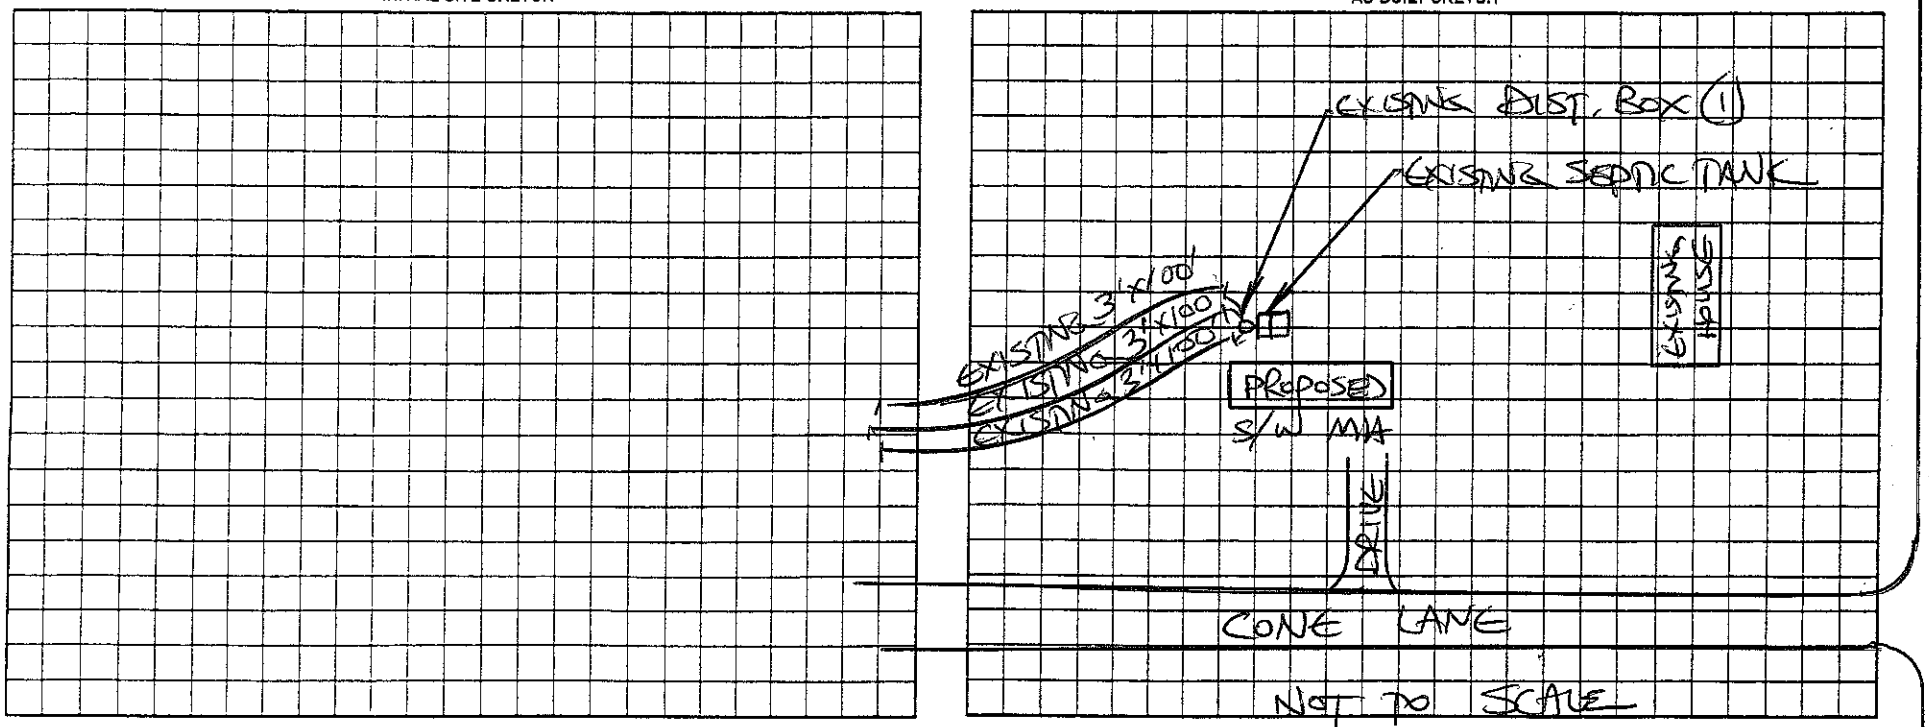

Permit can be suspended or revoked if any false information is supplied toward securing the permit/any unauthorized changes are made to the site/any unauthorized changes are made in the installation of the system. Improvement Permit with plat valid without expiration ☐ Improvement Permit with site plan valid for sixty months ☐ Authorization to Construct is valid for a period equal to that of Improvement Permit – not to exceed sixty months.

Signed: _____ date _____ Installed by: _____

Improvement Permit by: _____ date _____ Operation Permit by: _____ date _____

Authorization to Construct by: _____ date _____ Existing System Inspection by: STEVE HENDRICK date 3-12-07

HEALTH DEPT. COPY: WHITE OWNER COPY (FINAL): YELLOW OWNER COPY (INITIAL): PINK