IREDELL COUNTY HEALTH DEPARTMENT

STATESVILLE 704-878-5305 MOORESVILLE 704-664-5281

IMPROVEMENT PERMIT / AUTHORIZATION TO CONSTRUCT / OPERATION PERMIT / EXISTING SYSTEM INSPECTION

PERMIT# 74249 PIN# 4765 71 3088

OWNER OR CONTRACTOR A. J. Building Co. PHONE: Business 871-0940 Home

DATE 7-17-98

ADDRESS 146 Hunter Ridge Ln

LOCATION Bell Fm Rd TL Evergreen TR Birchwood TR Woodview lot left

SUBDIVISION Sunbrook BLOCK / SECTION II LOT 23 LOT AREA 100'X200' SITE CLASS PS DESIGN FLOW 360 L.T.A.R. .3

Septic Tank: 1000 Gallons: STB 1012 Date 3-18-98

Pump Tank: Gallons: PT Date

Pump Make: Model Serial No.

Nitrification Field: No Fields 1 Square Feet 400 Linear Feet 200

No Lines 3 Trench Width 24" Max Trench Bottom Depth 36" Gravel Depth N/K

☐ New System ☐ Repair System Type: I, II, III, IV, V, VI

System Description: Gravity Panels

Repair System Description: Pump to Panels

Maintenance Agreement Required: ☐ Yes ☐ No

☑ House/Mod. Home No. Bedrooms 3

☐ Mobile Home No. Bathrooms 2

☐ Business No. Employees

☐ Other


☐ Slab ☑ Crawl Space ☐ Basement w/plumbing ☐ Basement wo/plumbing

Water Supply: ☐ Individual ☑ Public ☐ Community


Comments:/Conditions: Start 12" Deeper Than Upper Drainline with French Drain + Run to Daylight.

Comments:/Conditions:

INITIAL SITE SKETCH

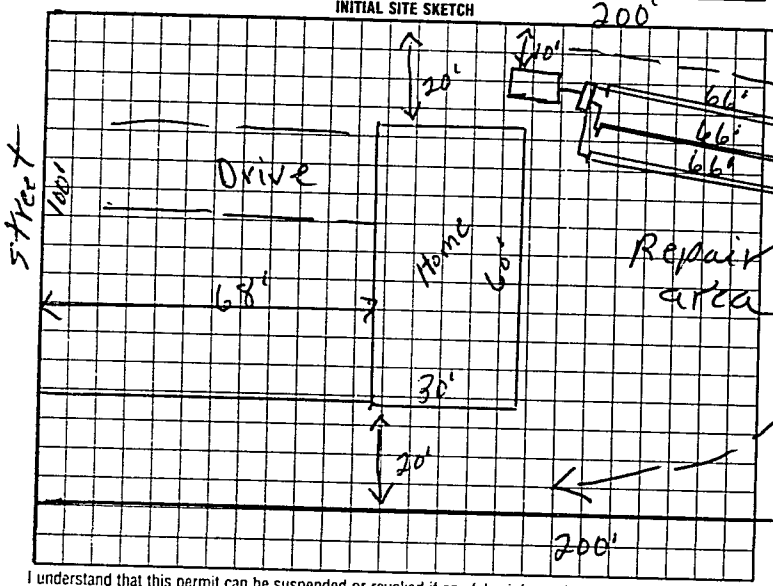

AS BUILT SKETCH

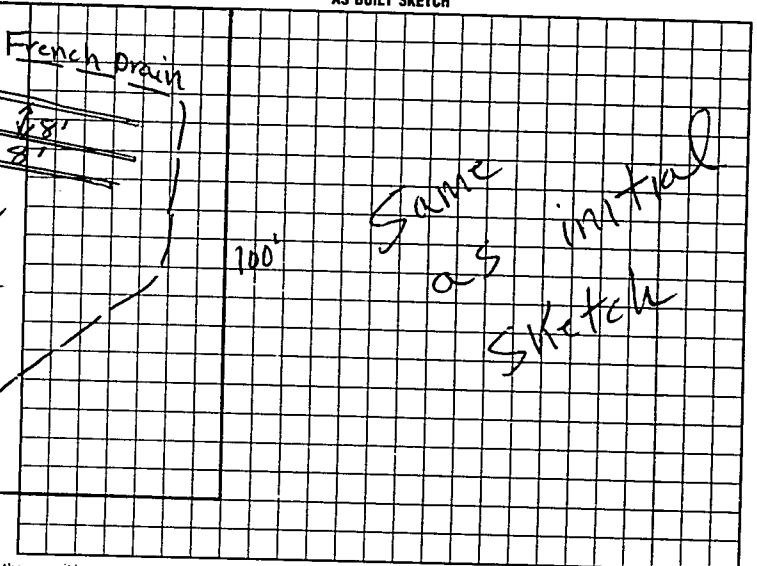

I understand that this permit can be suspended or revoked if any false information is supplied toward securing the permit/any unauthorized changes are made to the site/any unauthorized changes are made in the installation of the system. Improvement Permit with plat valid without expiration. Improvement Permit with site plan valid for sixty months. Authorization to Construct is valid for a period equal to that of Improvement Permit – not to exceed sixty months.

Signed: Jeffrey E. Whitaker date 7-22-98 Installed by: Steve Jordan

Improvement Permit by: R. C. Moore date 7-17-98

Authorization to Construct by: R. C. Moore date 7-17-98 Operation Permit by: R. C. Moore date 10-20-98

HEALTH DEPT. COPY (WHITE) INSPECTION COPY (FINAL) GREEN OWNER COPY (FINAL) YELLOW INSPECTION COPY (INITIAL) PINK OWNER COPY (INITIAL) GOLD

25708