IREDELL COUNTY HEALTH DEPARTMENT

STATESVILLE 704-878-5305 (C\) MOORESVILLE 704-664-5281

IMPROVEMENT PERMIT / AUTHORIZATION TO CONSTRUCT / OPERATION PERMIT / EXISTING SYSTEM INSPECTION

PERMIT# 1199 64 PIN# 4765-71-5326 DATE 5-20-04

OWNER OR CONTRACTOR SHULTZ HOUSING ADVANTAGE PHONE: Business % 704-902-1836 Home 704-883-9997

ADDRESS 734 KOA LANE STATESVILLE NC 28677

LOCATION US 64 E, TR BELL FARM RD, TL EVERGREENWOODS, TR BIRCHWOOD, TL WOODVIEW, AT END ON RIGHT

SUBDIVISION SUNBROOK BLOCK / SECTION II LOT 20/19 LOT AREA 0.458 ACRE SITE CLASS PS DESIGN FLOW 360 L.T.A.R.

Septic Tank: 1000 Gallons; STB 1012 Date 1-20-04
Pump Tank: Gallons; PT Date
Pump Make: Model Serial No.
Nitrification Field: No Fields 1 Square Feet Eq. to 1440 Linear Feet 360
No Lines FOUR Trench Width 36" Max Trench Bottom Depth 36" Gravel Depth N/A

☑ New System ☐ Repair System Type: I, II, (III), IV, V, VI
System Description: 25% REDUCTION, GRAVITY
Repair System Description: 50% REDUCTION, LOW-PRESSURE
Maintenance Agreement Required: ☐ Yes ☑ No

☐ House/Mod. Home ☑ Mobile Home ☐ Business ☐ Other
No. Bedrooms 3 No. Bathrooms 2 No. Employees


Water Supply: ☐ Individual ☑ Public ☐ Community

☐ Slab ☑ Crawl Space ☐ Basement w/plumbing ☐ Basement wo/plumbing

Comments/Conditions: ① SEE ATTACHED SEWAGE EASEMENT ② INSTALL 25% REDUCTION SYSTEM ON CONTOUR AS FLAGGED

Comments/Conditions: SEPTIC TANK INSTALLED WITH MARKER USING "TUFTITE" FILTER

INITIAL SITE SKETCH

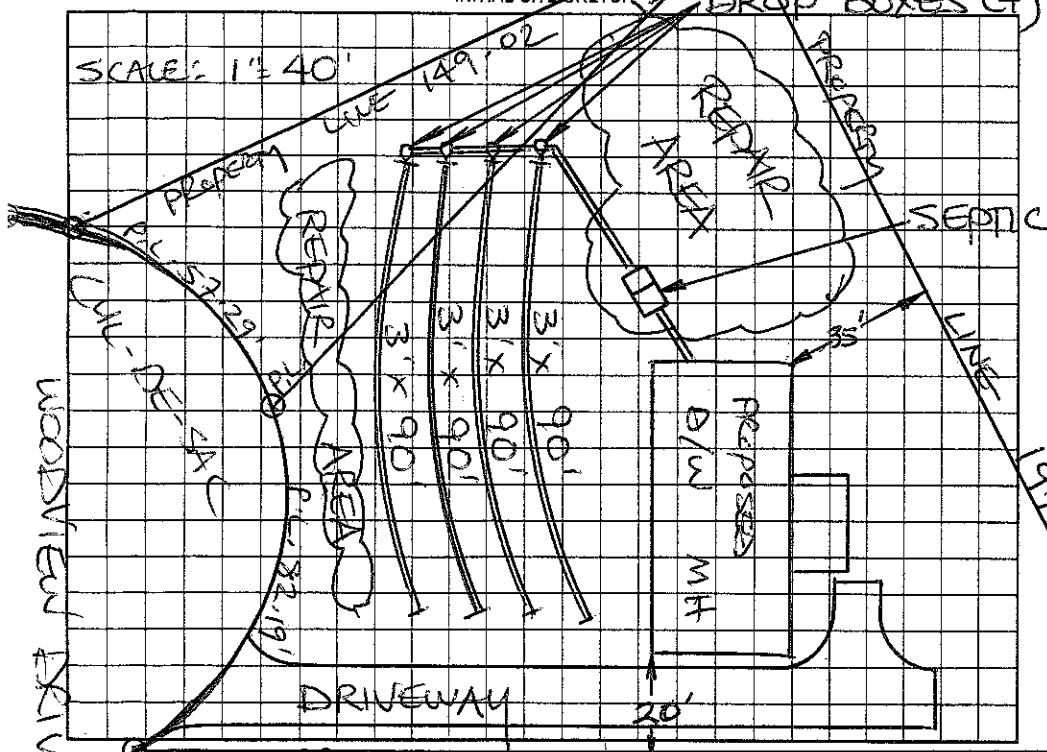

AS BUILT SKETCH

SYSTEM INSTALLED ACCORDING TO INITIAL SITE SKETCH USING 21% REDUCTION. (95 "QUICK 4" INFILTRATORS)

Permit can be suspended or revoked if any false information is supplied toward securing the permit/any unauthorized changes are made to the site/any unauthorized changes are made in the installation of the system. Improvement Permit with plat valid without expiration. Improvement Permit with site plan valid for sixty months. Authorization to Construct is valid for a period equal to that of Improvement Permit – not to exceed sixty months.

Signed Donald Schultz date 25 May 04 Installed by: A-1 BACKHOE

Improvement Permit by: STEVE HEDRICK date 5-20-04 Operation Permit by: STEVE HEDRICK date 6-14-04

Authorization to Construct by: STEVE HEDRICK date 5-20-04 Existing System Inspection by: date

HEALTH DEPT. COPY: WHITE OWNER COPY (FINAL): YELLOW OWNER COPY (INITIAL): PINK